

# Gerald & Mary Gould

Claim of Beneficial Use

For

Application R 84444


Permit R 12984

T 40 S, R 19 E, W.M.



Section 18

RECEIVED

MAILED 7/15  
DIVISION OF RESOURCES DEPT. OF AGRICULTURE  
SALEM, OREGON

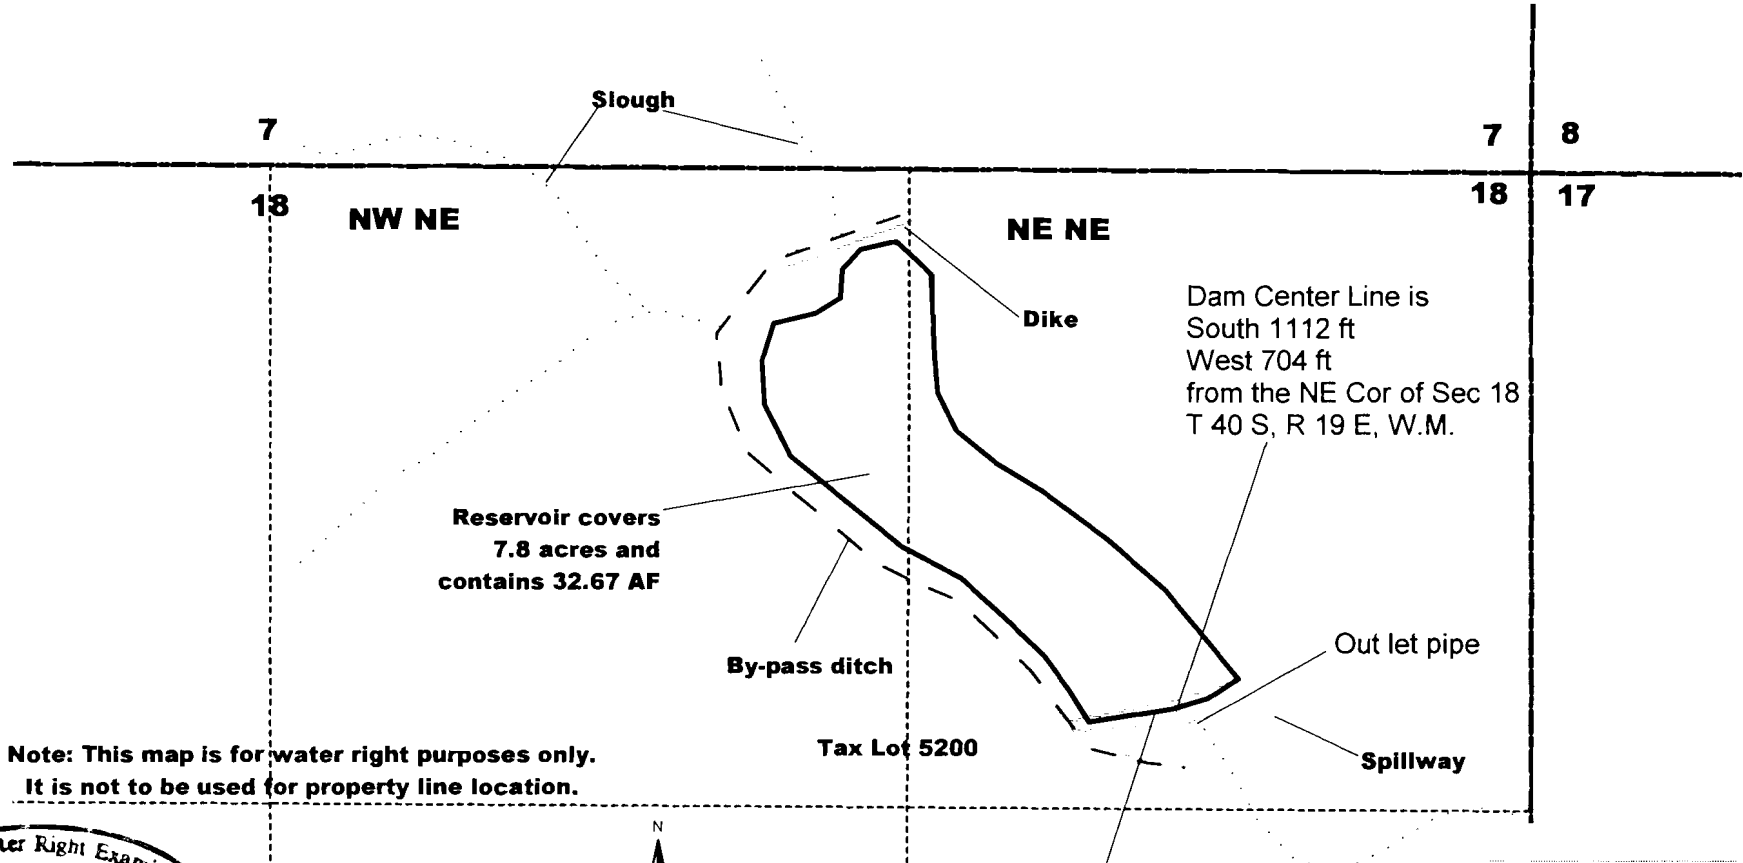

Note: This map is for water right purposes only.  
It is not to be used for property line location.

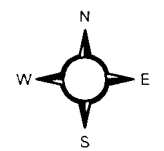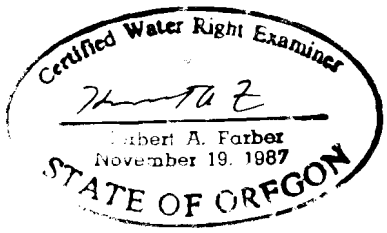

Scale 1" = 400'

**FARBER SURVEYING**  
PO Box 5286  
Central Point, Oregon 97502  
Phone 541-664-5599  
Fax 541-664-5603  
Email [hfarber@clartco.net](mailto:hfarber@clartco.net)

Farber & Sons, Inc.  
431 Oak Street  
Central Point, Oregon  
Tax ID: 95-1057173

RENEWAL DATE 12 31 2005