


T. 8S., R. 42E., W. M.

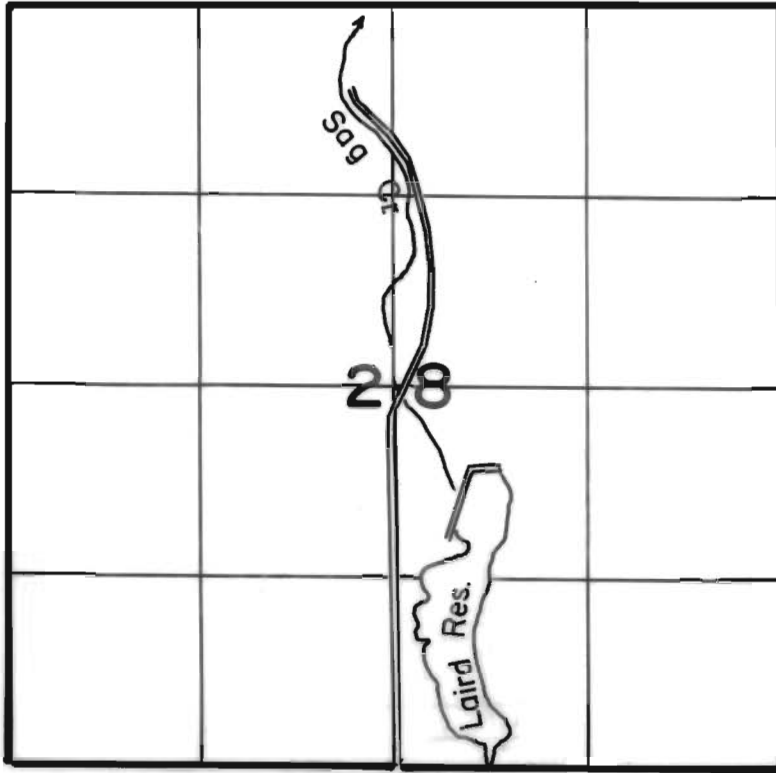

SCALE 1" = 1320'

The purpose of this map is for identifying the location of the water right only and is not intended to provide legal dimensions of property ownership lines

FINAL PROOF SURVEY

UNDER

APPL. R-72487
R-72487

PER. R-11844
R-11769

IN NAME OF

JERRY B. & JEANETTE TORRANCE

SURVEYED SEPT. 24, 1999

RECEIVED

OCT 01 1999

WATER RESOURCES DEPT.
SALEM, OREGON

