


# Groundwater Application - Agricultural Use

## Quiet Meadows Farm, LLC

Township 10S, Range 2W, W.M.

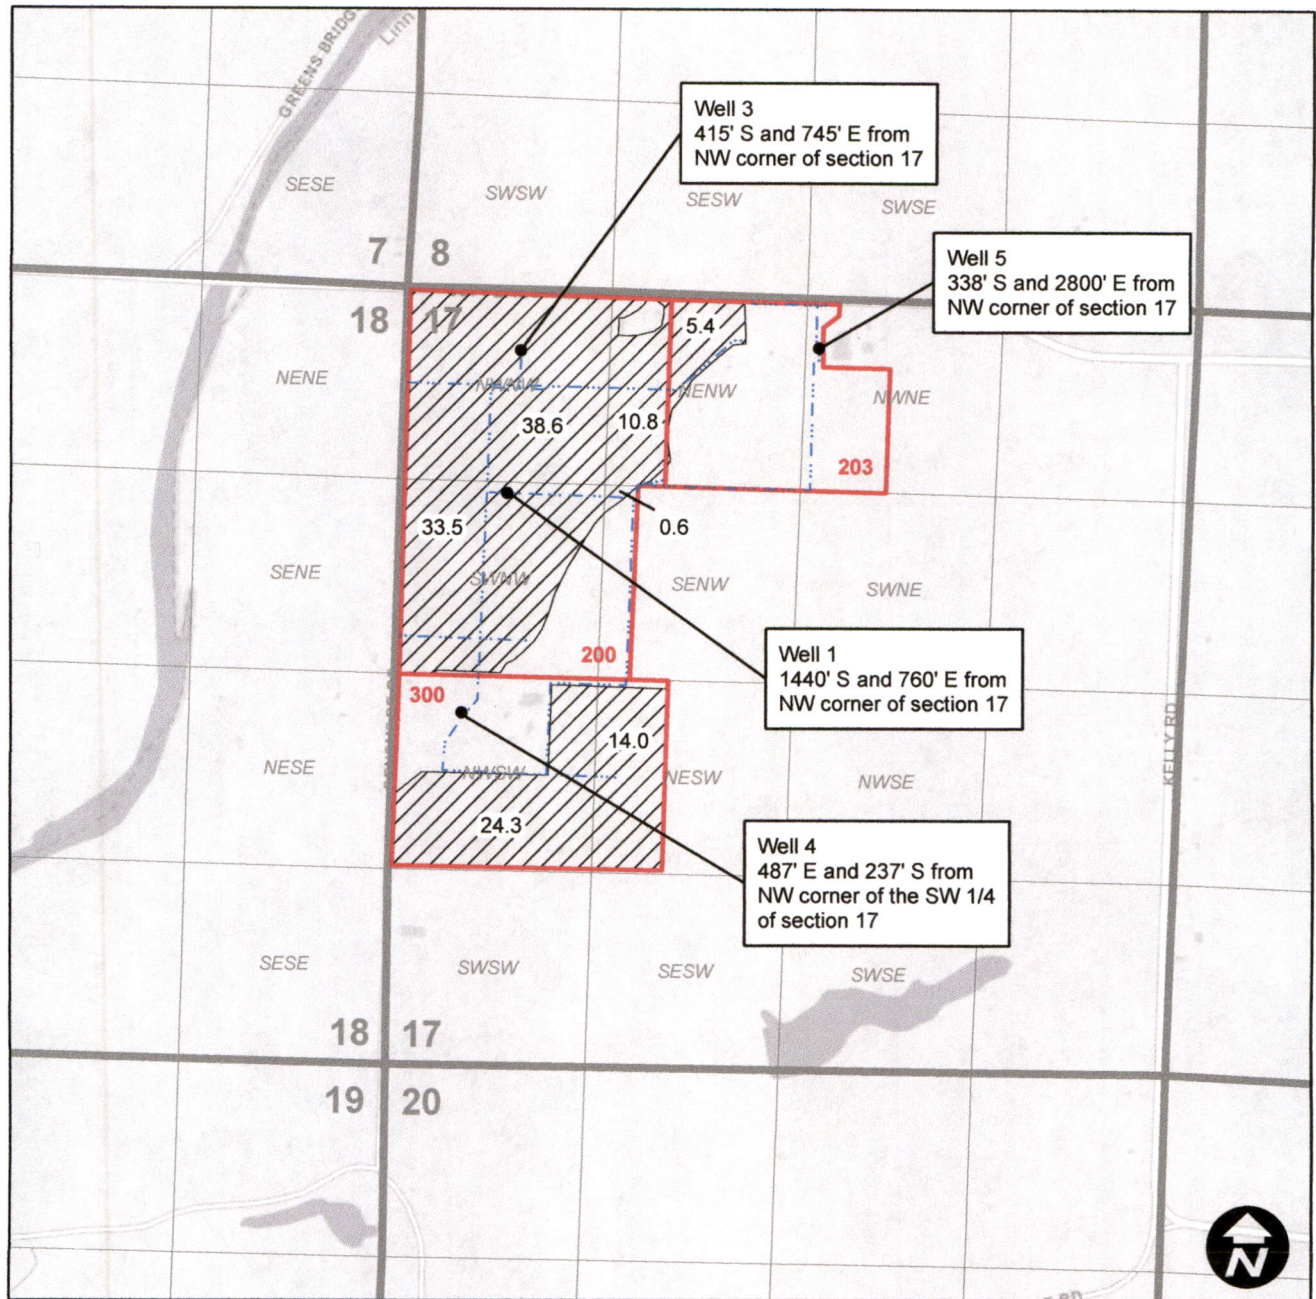

### Legend

- AG POU
- Mainline
- Taxlot

Received by OWRD

JUN 28 2024

Salem, OR