


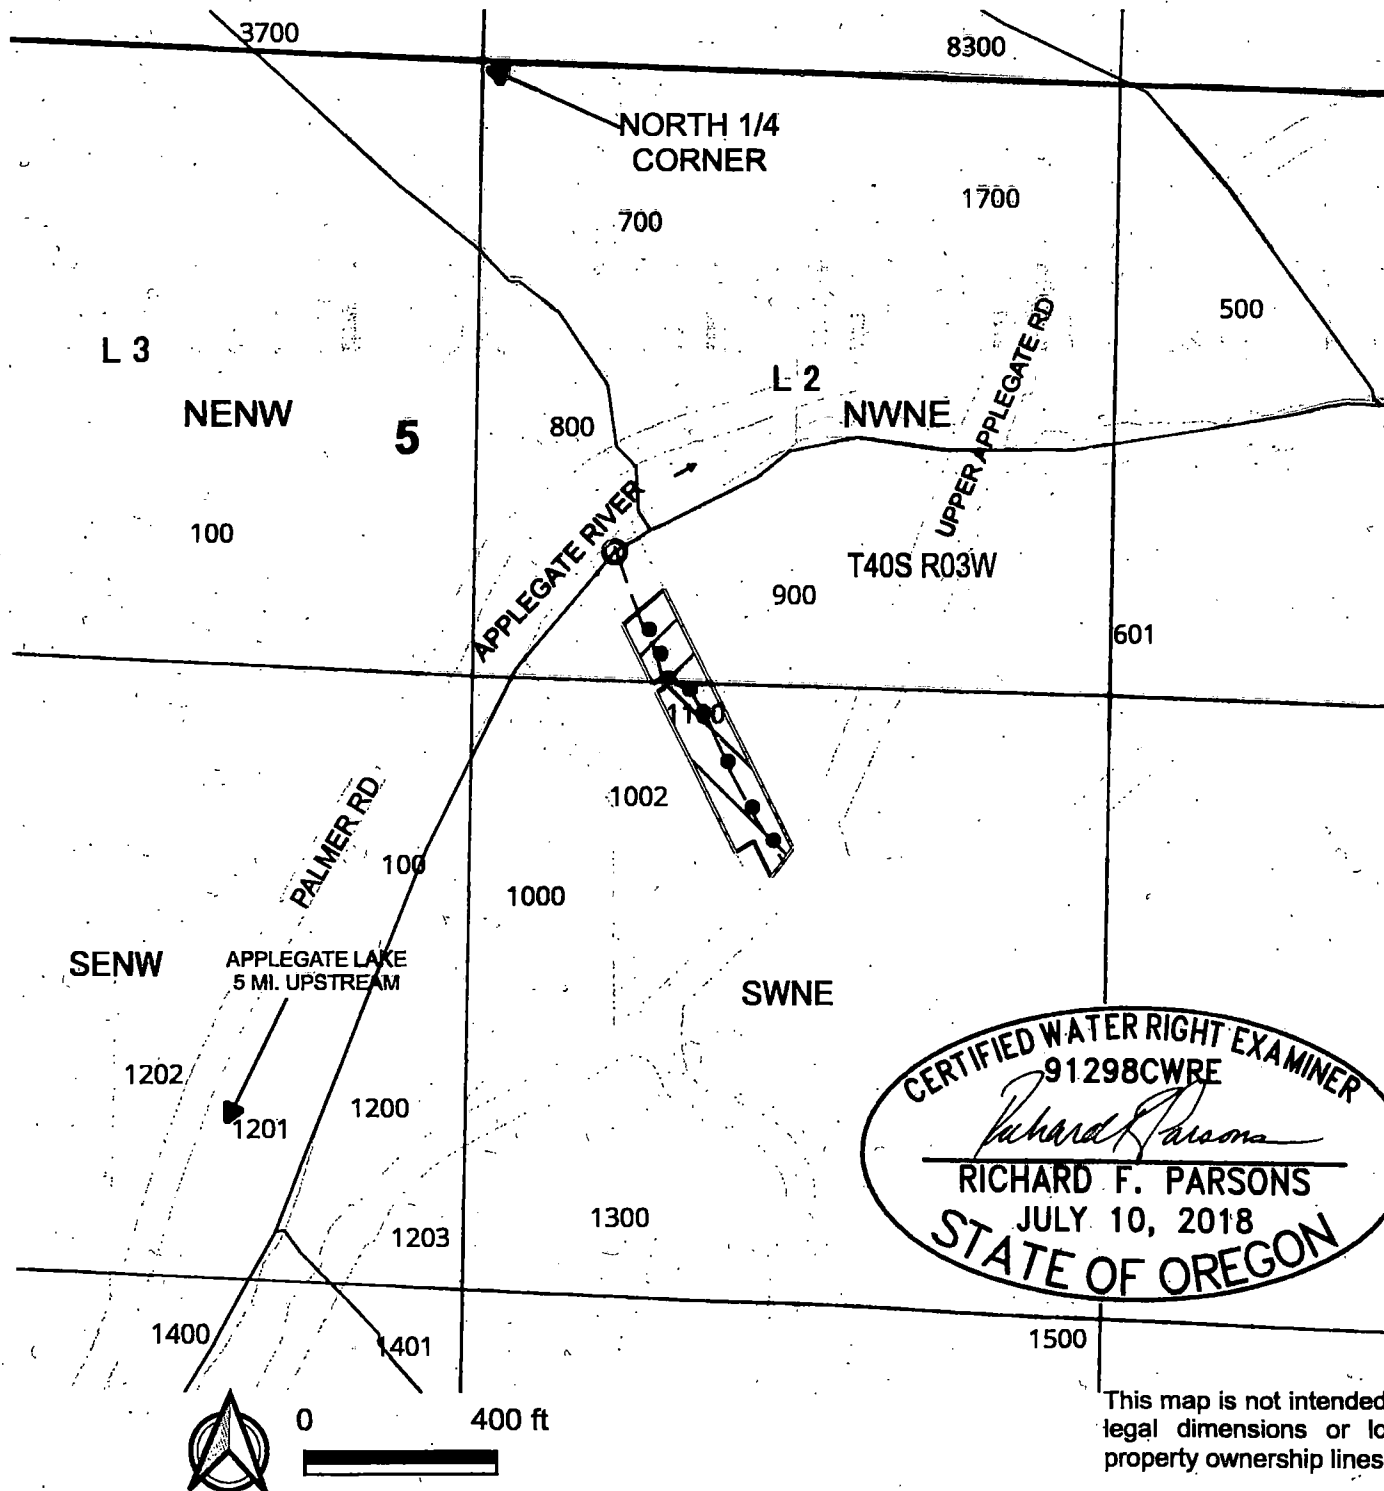

WARNER (RONALD) THAMES
9658 UPPER APPLGATE RD
JACKSONVILLE, OR 97530

CLAIM OF BENEFICIAL USE
APPLICATION NO. S-88839
PERMIT NO. S-55287

SITUATED IN
SECTION 5, TOWNSHIP 40S,
RANGE 3W, W.M.
JACKSON COUNTY, OREGON

LEGEND

○ POD, METER, FISH SCREEN
 1025' SOUTH AND 295' EAST OF
 NORTH QUARTER CORNER
 SECTION 5

● SPRINKLERS

PLACE OF USE - 1.45 ACS



NW NE - 0.45 ACS (LOT 2)



SW NE - 1.0 ACS

— PIPELINES

Received

JUL 10 2018

OWE

This map is not intended to provide
 legal dimensions or locations of
 property ownership lines

ParsonsWater Consulting LLC
 rick.parsons@parsonwater.com
 541.499.0257 303.667.5067