


T1S., R3E., W.M.

RECEIVED

SEP 10 1999

WATER RESOURCES DEPT
SALEM, OREGON

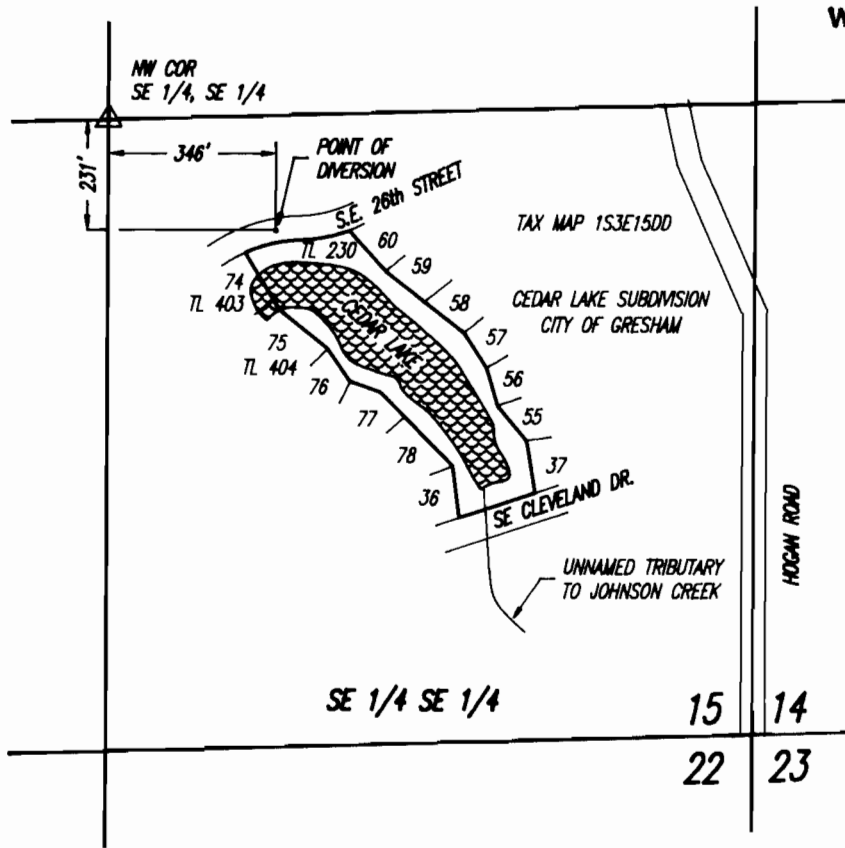

FINAL PROOF SURVEY


UNDER

Application No. R-72579 Permit No. R-11582


IN NAME OF

LES and PAT BROWN

Surveyed July 12, 1999, by JOHN R. THOMAS

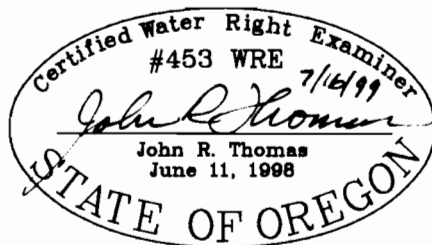

SCALE: 1" = 400'

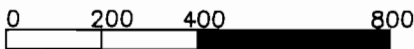

EXPIRES 06/30/00

THIS MAP IS FOR THE PURPOSE OF IDENTIFYING THE LOCATION OF THE WATER RIGHT ONLY AND IS NOT INTENDED TO PROVIDE LEGAL DIMENSIONS OR THE LOCATION OF PROPERTY OWNERSHIP LINES.