


LEGEND

- | | | | | | |
|--|------------------------------|--|---------------------------|--|-------------|
| | Point of Appropriation (POA) | | City Boundary | | Railroad |
| | Meter | | Tax Lot | | Watercourse |
| | Conveyance Line | | Donation Land Claim (DLC) | | Waterbody |
| | Proposed Place of Use | | Major Road | | |
| | Service Area Boundary | | | | |

**Claim of Beneficial Use Map
City of Wood Village, OR
T-11617**

Township 1 North, Range 3 East (W.M.)

CERTIFIED WATER RIGHTS EXAMINER STAMP

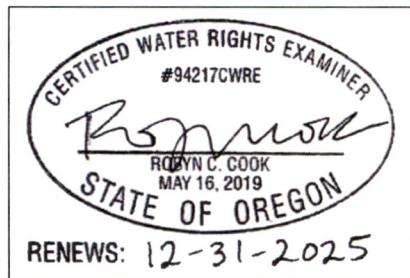

Received
JUL 11 2024
OWRD

LOCATION DESCRIPTION

Well #2
Located 50 feet South and 440 feet East from the SE corner of DLC 41, Township 1 North, Range 3 East (W.M.)
Well #3
Located 1,510 feet North and 1,290 feet West from the SE corner of Section 27, Township 1 North, Range 3 East (W.M.)

DISCLAIMER
This map was prepared for the purpose of identifying the location of a water right only and it is not intended to provide legal dimensions or location of property ownership lines.

Date: June 17, 2024
Data Sources: BLM, ESRI, OWRD, USGS

