


CLAIM of BENEFICIAL USE
FOR GARY CANNON
BY NATHAN REED PE CWRE
T30S, R15W, W.M. SECTION 12
TRANSFER NO.: T-14076


DATE SURVEYED: JUNE 29, 2024

SCALE: 1" = 400'

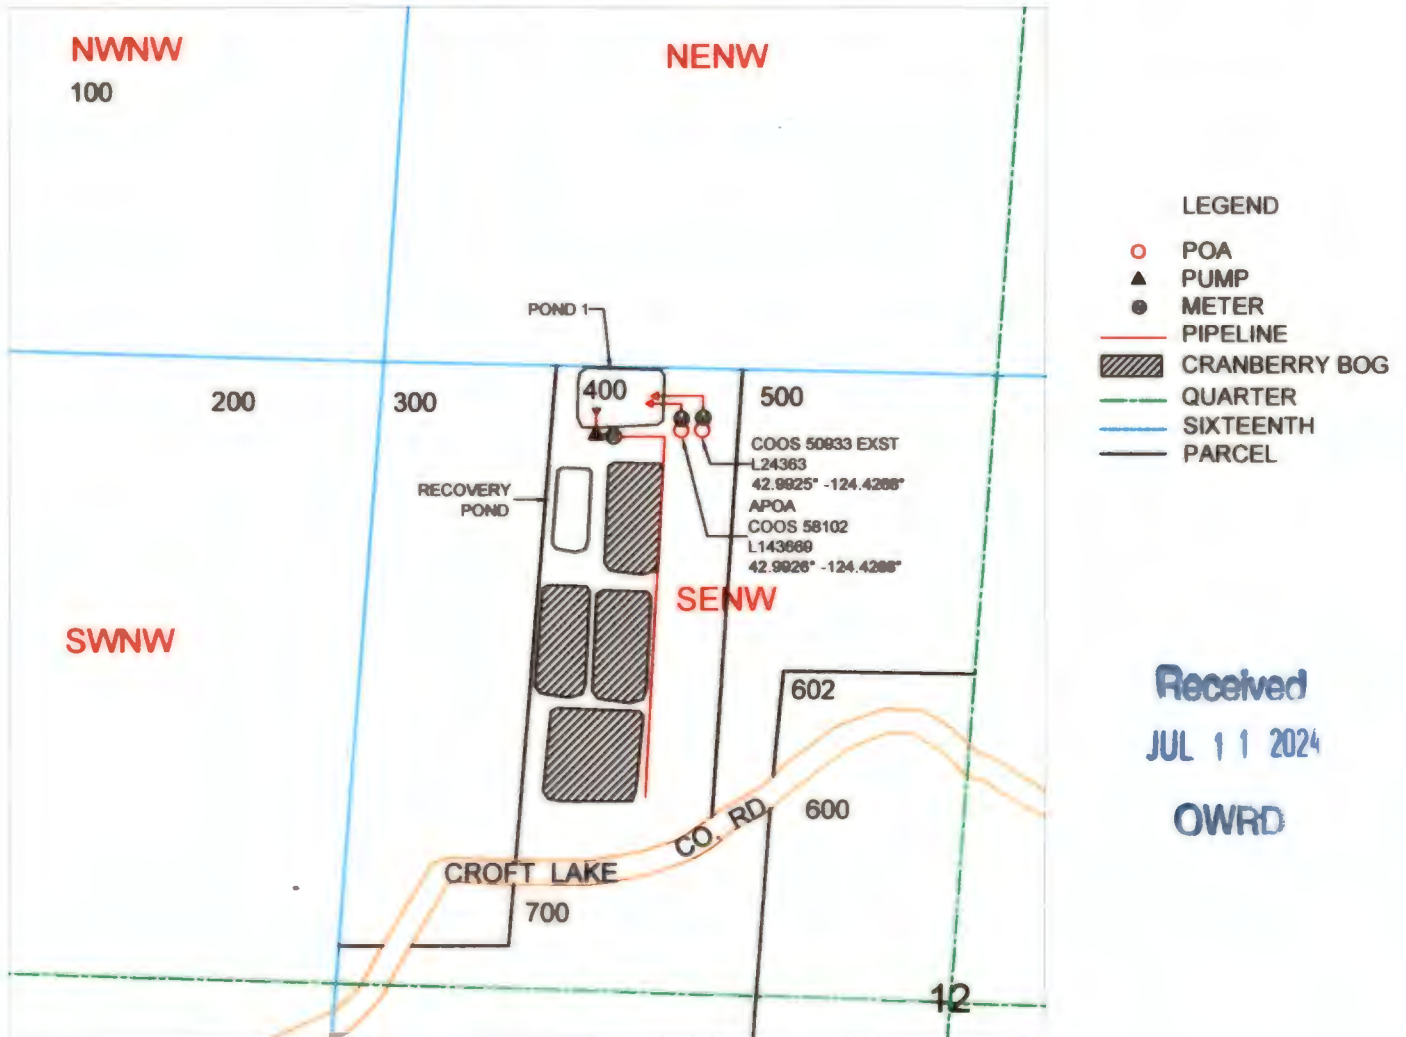

THE EXISTING POA IS LOCATED 1130 FEET NORTH & 555 FEET WEST FROM THE C1/4 OF SECTION 12.

THE NEW APOA IS LOCATED 1130 FEET NORTH & 600 FEET WEST FROM THE C1/4 OF SECTION 12.

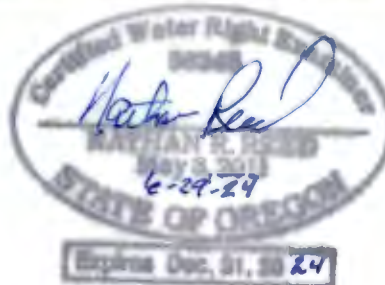

MAP PREPARED FOR:
GARY CANNON
47338 FLORAS LAKE LOOP
LANGLOIS, OR 97450

THE PURPOSE OF THIS MAP IS TO IDENTIFY THE LOCATION OF THE WATER RIGHT. IT IS NOT INTENDED TO PROVIDE INFORMATION RELATIVE TO THE LOCATION OF PROPERTY OWNERSHIP BOUNDARY LINES.

MAP PREPARED BY:
NATHAN REED PE, CWRE
157 WEST BODIE STREET
ROSEBURG, OR 97471