


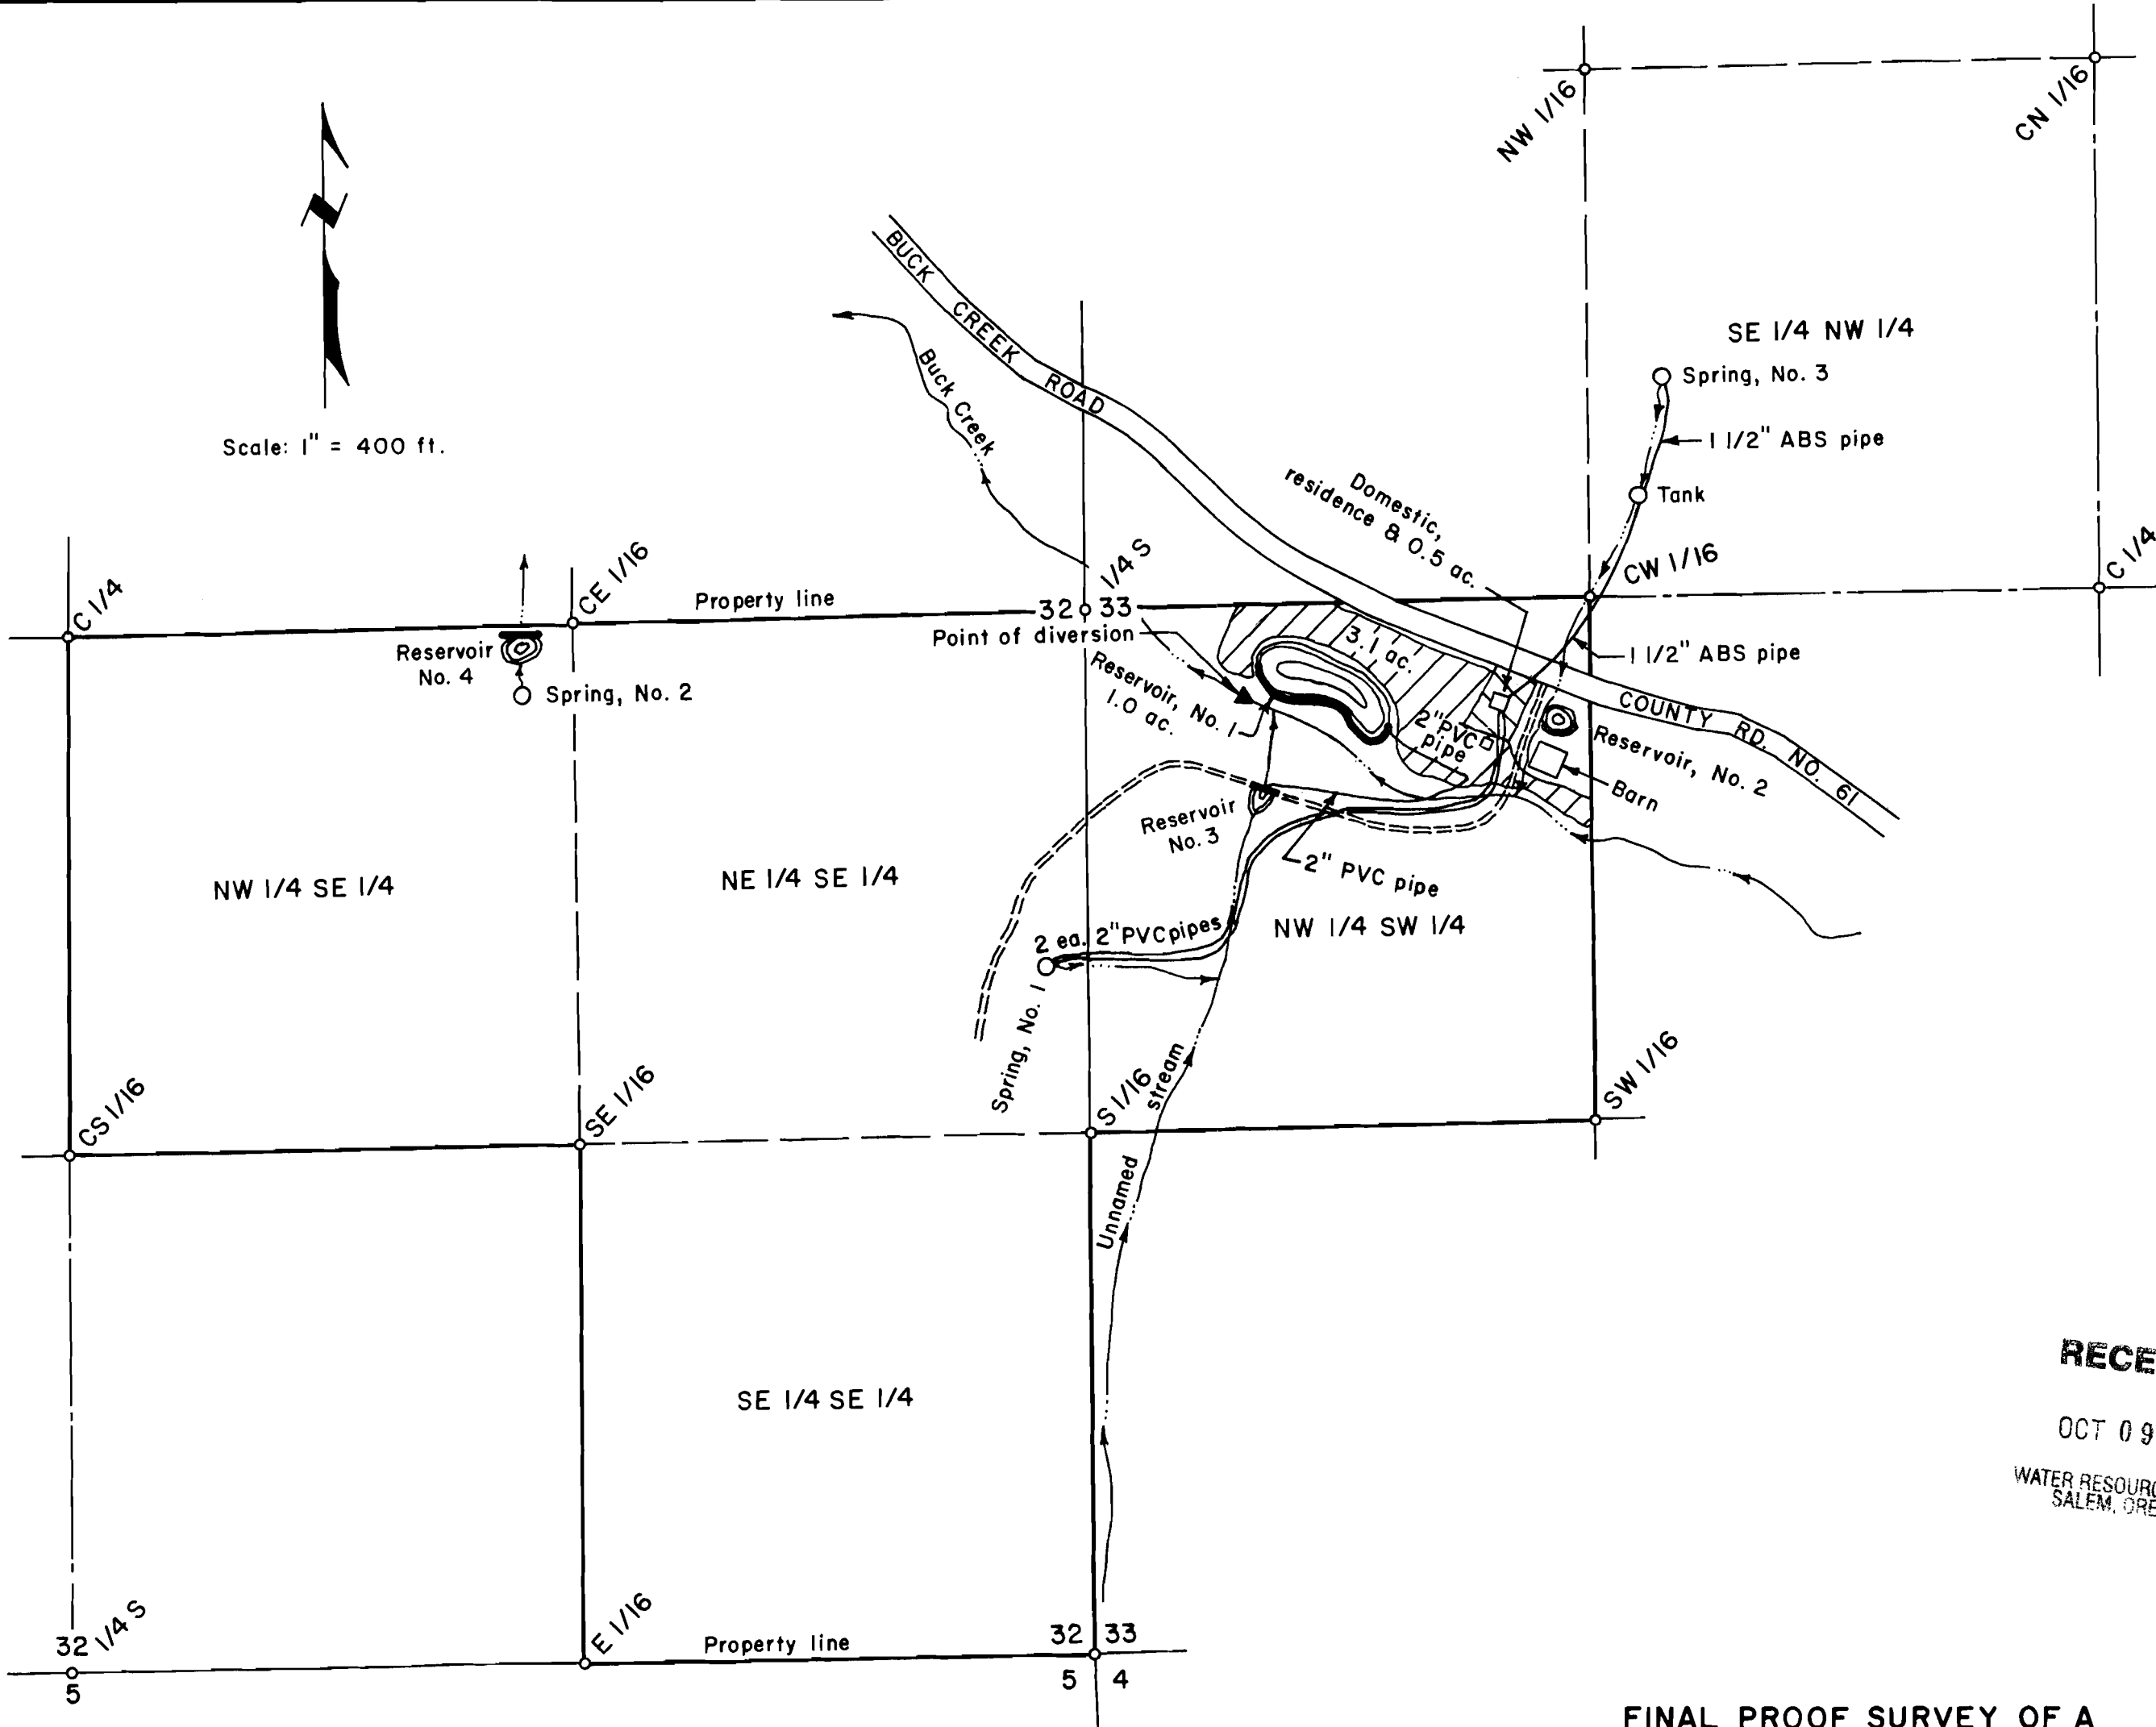

Scale: 1" = 400 ft.



RECEIVED

OCT 09 1998

WATER RESOURCES DEPT.
SALEM, OREGON

SPRING & CREEK POINTS OF DIVERSION


1. Spring, 920 ft. South & 110 ft. West of the east 1/4 corner of Section 32.
2. Spring, 100 ft. South & 1,450 ft. West of the east 1/4 corner of Section 32.
3. Spring, 560 ft. North & 1,490 ft. East of the west 1/4 corner of Section 33.
4. Buck Creek ▲, 230 ft. South & 400 ft. East of the west 1/4 corner of Section 33.

RESERVOIR POINTS OF DIVERSION

1. 230 ft. South & 400 ft. East of the west 1/4 corner of Section 33.
2. 350 ft. South & 1,190 ft. East of the west 1/4 corner of Section 33.
3. 470 ft. South & 460 ft. East of the west 1/4 corner of Section 33.
4. 60 ft. South & 1,450 ft. West of the east 1/4 corner of Section 32.

**FINAL PROOF SURVEY OF A
PERMIT TO CONSTRUCT RESERVOIRS AND A
PERMIT TO APPROPRIATE SURFACE WATER
FROM THE SE 1/4 OF SECTION 32 AND THE
SE 1/4 NW 1/4 & THE NW 1/4 SW 1/4 OF
SECTION 33, T 21 S, R 4 W, W. M.,
DOUGLAS COUNTY, OREGON**

**Application Nos. R-72664 & S-72665
Permit Nos. R-12190 & 53186**

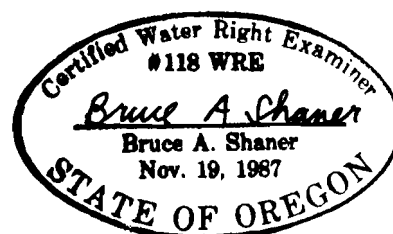

For: Dale A. Cuyler &
Brenda L. Woodard
2585 Buck Creek Road
Drain, Oregon 97435

By: Shaner Engineering, Inc.
P. O. Box 1430
Roseburg, Oregon 97470

September 25, 1998