

Ruckles Creek to Powder River

R41E R42E

CLAIM OF BENEFICIAL USE - 9/25/01

Application No. R-72391

Permit No. R-12220

Tax Lots 9 42 3100 & 10 42 800 - Baker County


For:

Duncan S. MacKenzie &
Elizabeth Harrell-MacKenzie
19265 Chandler Lane
Baker City, OR 97814

Scale 1" = 2,000'



This map is for the purpose of identifying the location of the water right only and has no intent to provide dimensions or location of property ownership lines.

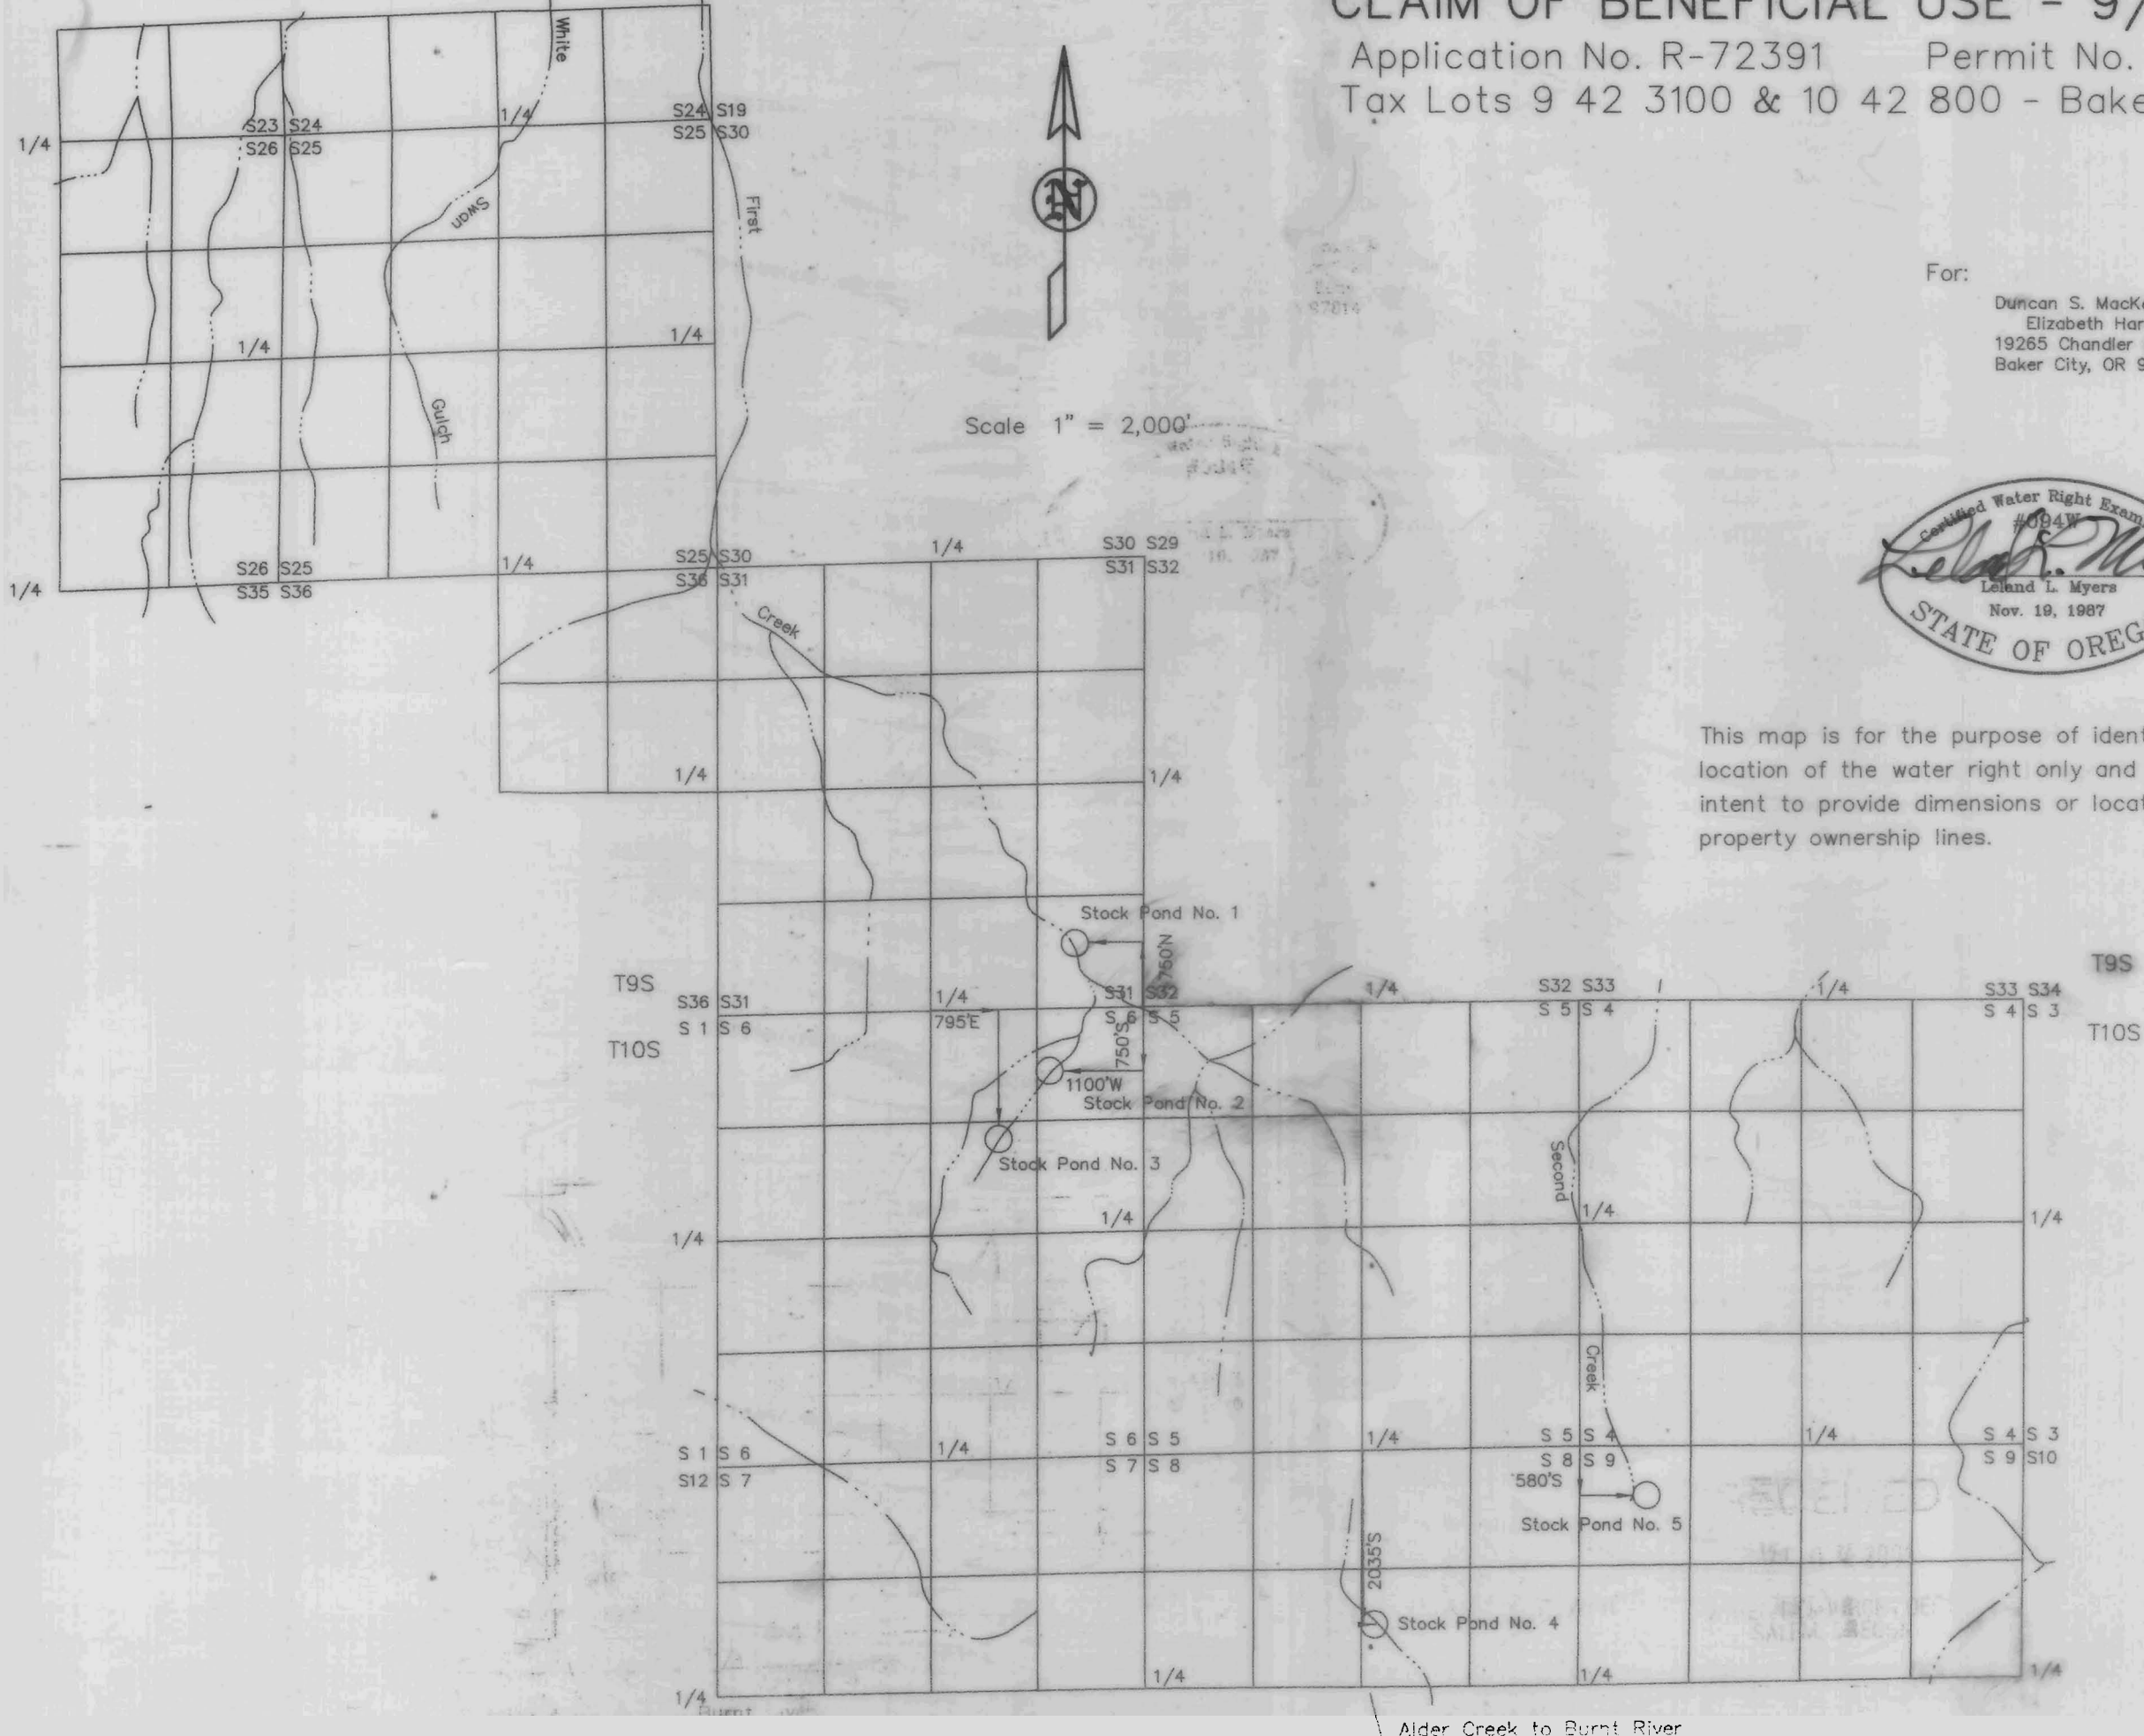

REC

OCT 04 2001

WATER RESOURCES DEP
SALEM, ORE