


Township 385, Range 1E.

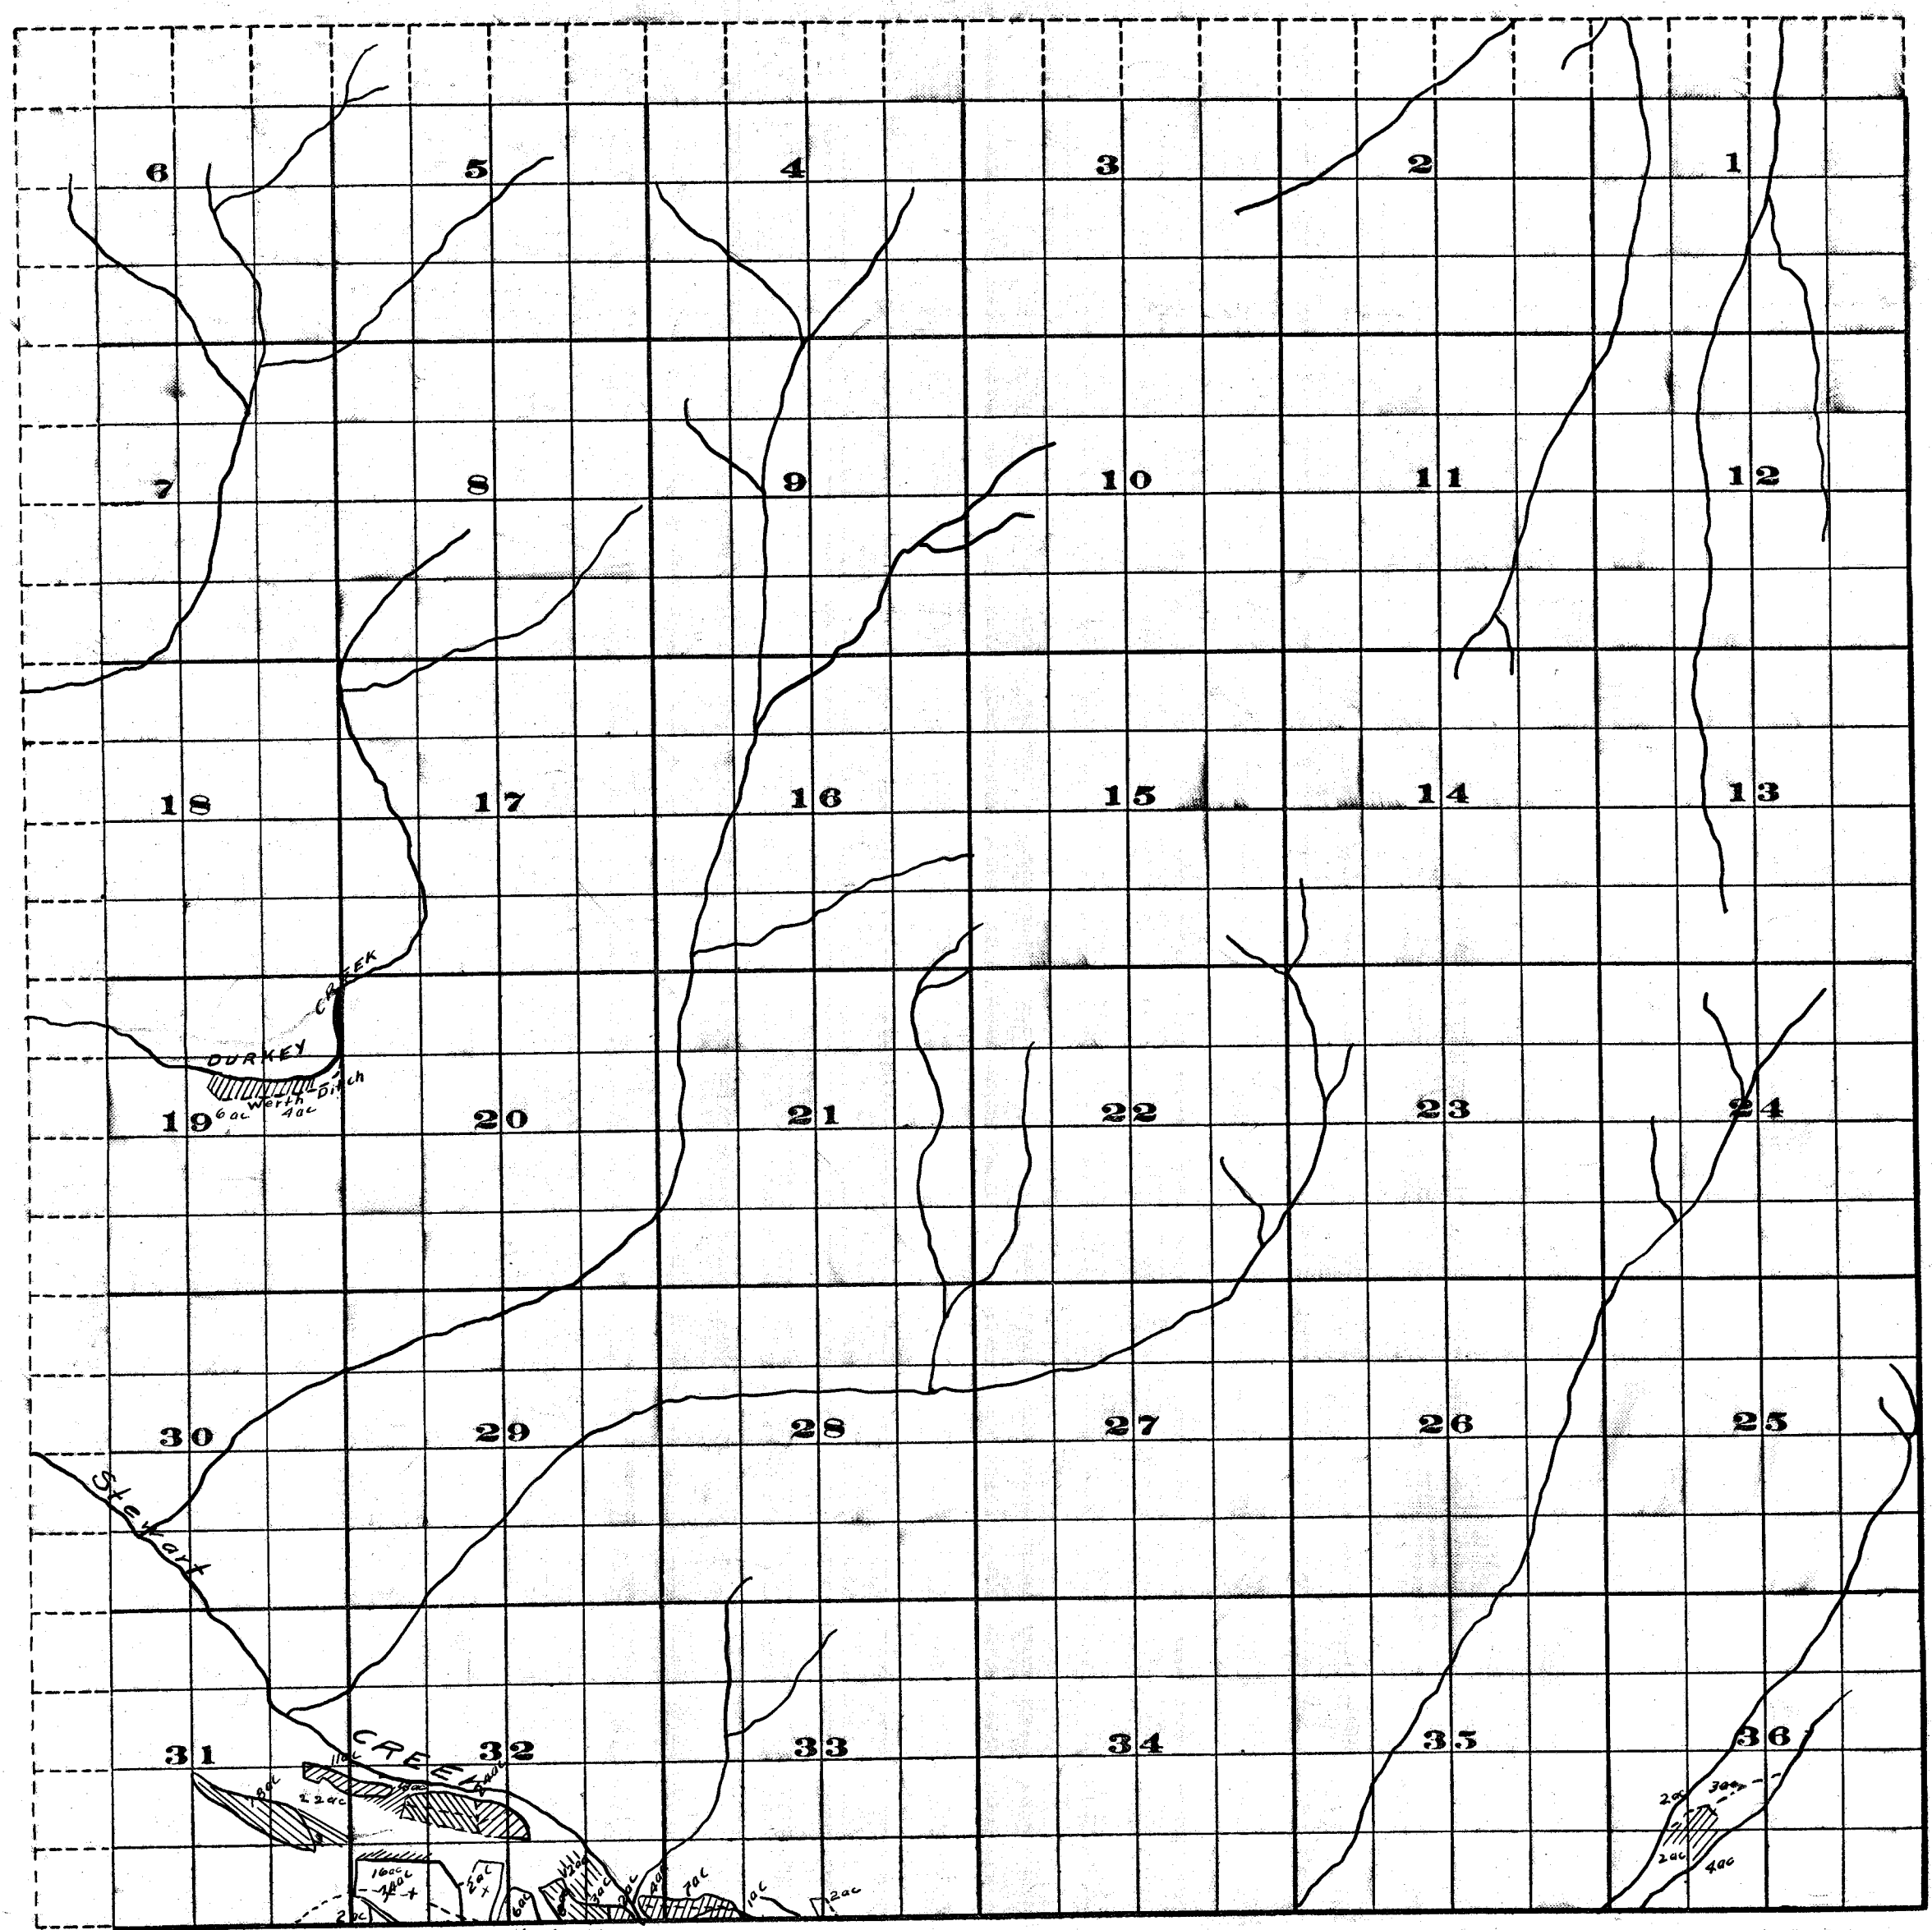

Survey by H.D. Farmer July 1911

FROM OFFICE OF THE STATE ENGINEER, SALEM, OREGON

M.D.
Q.E.M. 1116-11

Scale of Feet.

Adjudication

Rogue River and Tributaries

John H. Lewis State Engr.

Examined Sept. 18 1911.

385. 1E.