



March 9, 1995

Oregon

L ROBERT FORBES

3760 ALTA VISTA RD  
EAGLE POINT, OR 97524

WATER  
RESOURCES  
DEPARTMENT

REFERENCE: File # P-77925;  
Notice of Exempt Reservoir (Pond)

Your exempt reservoir notice has been received by the Department and has been assigned the above-referenced file number. We would like to ask you to refer to this number if you should need to contact us about the notice, your pond, or ponds if you have more than one.

To avoid any misunderstanding, we feel it is important to tell you that although we have received and filed your notice, we have not yet determined whether you are exempt from water right requirements. The watermaster responsible for the area in which the pond(s) is (are) located will help us apply the Water Resources Commission's administrative rules to your situation. These rules set the standards that determine which ponds require water rights and which are exempt. We will let you know the results as soon as we are able to complete our review of your pond(s)'s nature.

Since the department must rely initially on the information you submit to us, it is very important that the information be complete and accurate. If inspections show that your pond(s) does (do) not qualify as exempt, you could be asked to drain the pond(s) or submit a water right application or both. If you submit your application after January 1, 1995, it will be processed like any other application, since that is the deadline for filing water rights under the pond amnesty program.

The department will process your information as quickly as possible. However, because water right processing staff members are working hard to reduce a backlog of applications, it may be some weeks before you hear from us.

If you have questions, you may contact your watermaster. The enclosed brochure lists watermaster names, telephone numbers and addresses by county.

Sincerely,



Mr. Cory C. Engel  
Water Rights Research Assistant  
Water Rights/Adjudication Division

Enclosure: New Water Right Law for Pond Owners Brochure



Commerce Building  
158 12th Street NE  
Salem, OR 97310-0210  
(503) 378-3739  
FAX (503) 378-8130

STATE OF OREGON  
WATER RESOURCES DEPARTMENT

RECEIVED

DEC 20 1994

WATER RESOURCES DEPT.  
STATE OF OREGON

NOTICE OF EXEMPT RESERVOIR

This notice is submitted pursuant to ORS 537.141, which provides that a water right is not needed for certain ponds/reservoirs which were in existence before January 1, 1993, are located off-channel and store less than 9.2 acre-feet of water or have a dam less than 10 feet in height.

Landowner: L. ROBERT Forbes

Authorized Agent: (if applicable) \_\_\_\_\_

Address: 3760 Alta Vista Road

Eagle Point Or 97524 826 4661  
City State Zip Telephone No.

I/WE SUBMIT NOTICE OF THE FOLLOWING RESERVOIR(S):

NOTE: Multiple reservoirs may be included in a single notification, provided the reservoirs are within the same ownership, on contiguous property and within the same drainage basin. For items 1-6 below, attach extra sheets for additional reservoir descriptions.

1. The reservoir is located in Section 12 + 13, Township 36, Range 1W, in Jackson County. (Enclose a US Geological Survey topographical map or a tax lot map showing the location of the reservoir(s). Copies of portions of the maps are acceptable, provided information on the copy verifies the correct legal description.)

2. Source of water: Eagle Point Irrigation District

3. Maximum height of the dam: 7 ft

4. Maximum water depth in the reservoir: 7 ft

5. Maximum storage capacity of reservoir: 3.24 acre ft.

6. Size, description and location of any outlet pipe: 12 inch Pipe 3 ft from top of dam

7. Enclose evidence that the reservoir(s) existed before January 1, 1993, such as one or more of the following:

- 7.1 A dated aerial photograph which shows the immediate area above, below and surrounding the reservoir(s);
- 7.2 An affidavit signed by the landowner or other knowledgeable person (signature needs to be notarized);
- 7.3 A dated map prepared by a local, state or federal agency showing the location of the reservoir; or
- 7.4 Construction receipts or other forms of documentation.

Application No. P-77925  
Permit No. \_\_\_\_\_

RECEIVED

DEC 20 1994

WATER RESOURCES DEPT  
SALEM, OREGON

**Declaration by Owner/Authorized Agent:**

Each of the reservoirs described herein was in existence before January 1, 1993, is located off-channel and stores less than 9.2 acre-feet of water or has a dam less than 10 feet in height.

I/We believe the reservoir(s) qualifies under ORS 537.141 and OAR 690-11-041 for exemption from Oregon's water right filing requirements.

**Notice to Owners/Authorized Agent:**

Reservoirs that qualify for exemption under ORS 537.141 and OAR 690-11-041 shall be subject to the following conditions:

1. The right to store or use water in the reservoir shall not have priority over any water right; and
2. The right to store and use water in the reservoir(s) shall be subordinate to all future permitted or certificated water rights.

THE UNDERSIGNED VERIFIES THAT TO THE BEST OF HIS/HER KNOWLEDGE AND BELIEF THE INFORMATION CONTAINED IN THIS NOTICE IS TRUE, CORRECT AND COMPLETE.

Landowner/agent signature: *Robert Luba*

(Print Name and Title) \_\_\_\_\_

Date: 12-12-94

**FOR WATER RESOURCES DEPARTMENT USE ONLY**

The foregoing Notice and accompanying data have been examined by authorized staff of the Water Resources Department. Based on review of the information submitted, this Notice is accepted on \_\_\_\_\_, 1994 and assigned FILE NUMBER \_\_\_\_\_.

cc: Watermaster District # \_\_\_\_\_  
To Data Center (date) \_\_\_\_\_

lot 4

Bigham Rd.

Rd.

503 11

11

RECEIVED

DEC 20 1994

WATER RESOURCES DEPT. SALEM, OREGON

SEE INSERT (B-B) THIS PAGE

Riley Rd.

Application No P-77925  
Permit No.

Antelope Creek

Creek

14


13

12

Meridian Rd.

lot 4

Woods

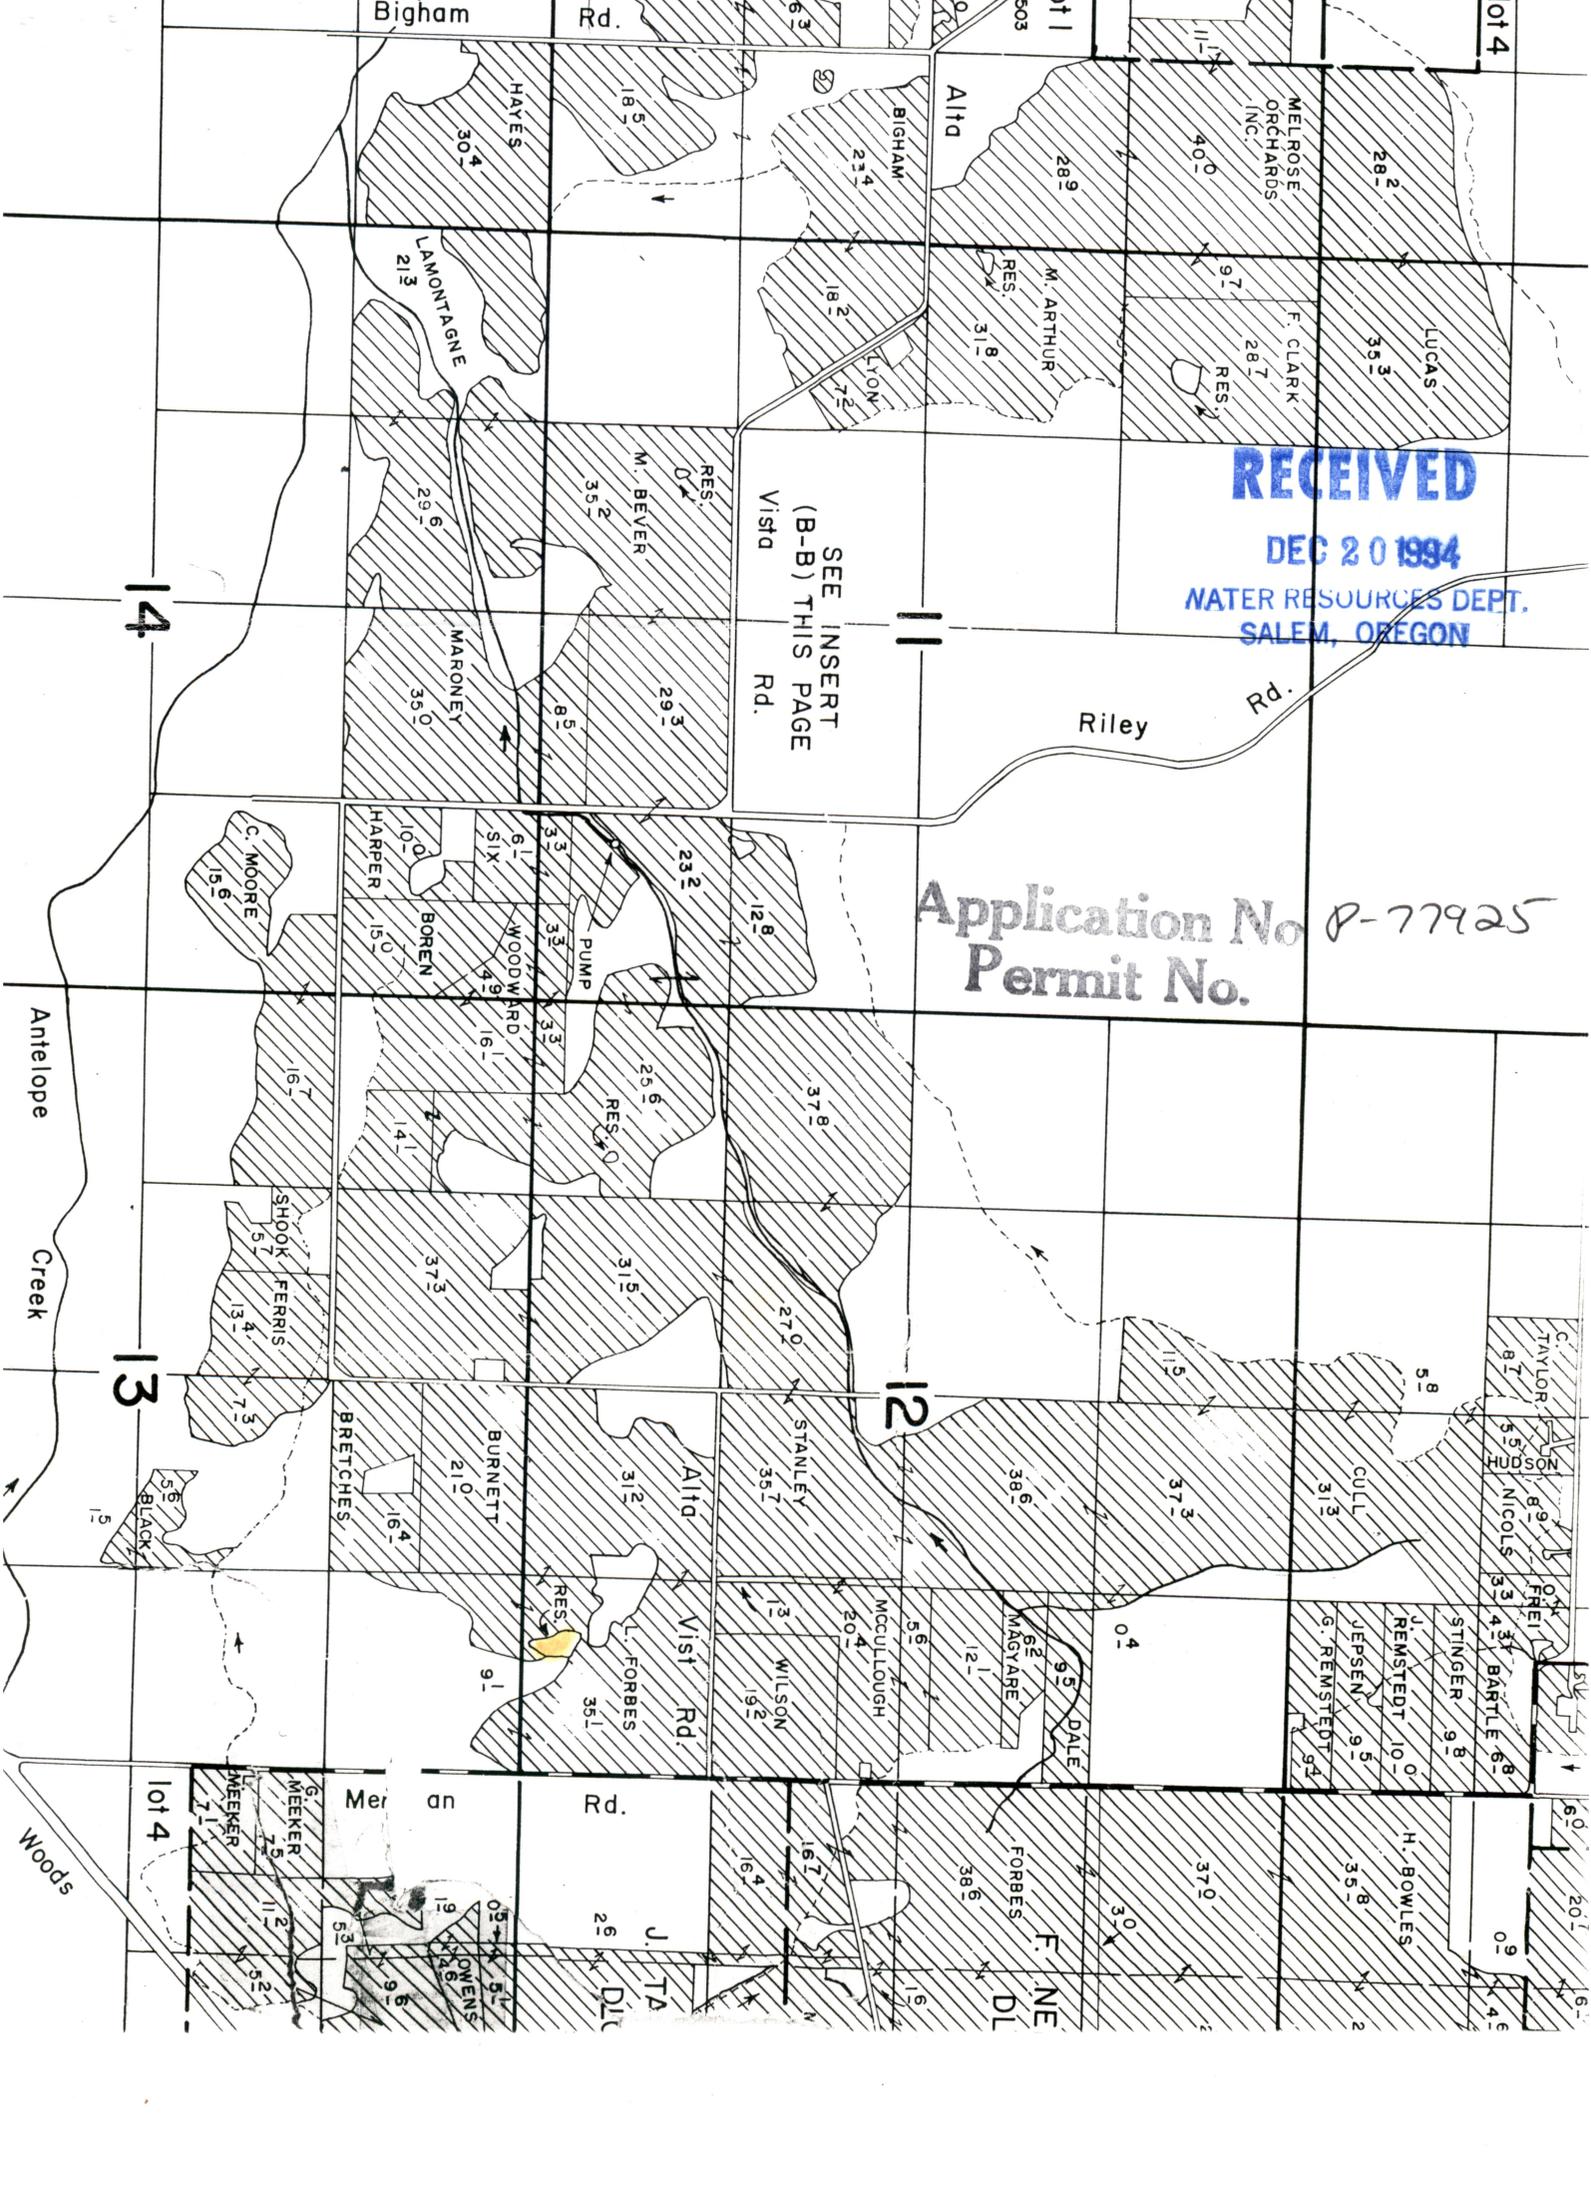


1. This Pond was on the property when I bought it in 1974

RECEIVED

DEC 20 1994

WATER RESOURCES DEPT  
SALEM, OREGON

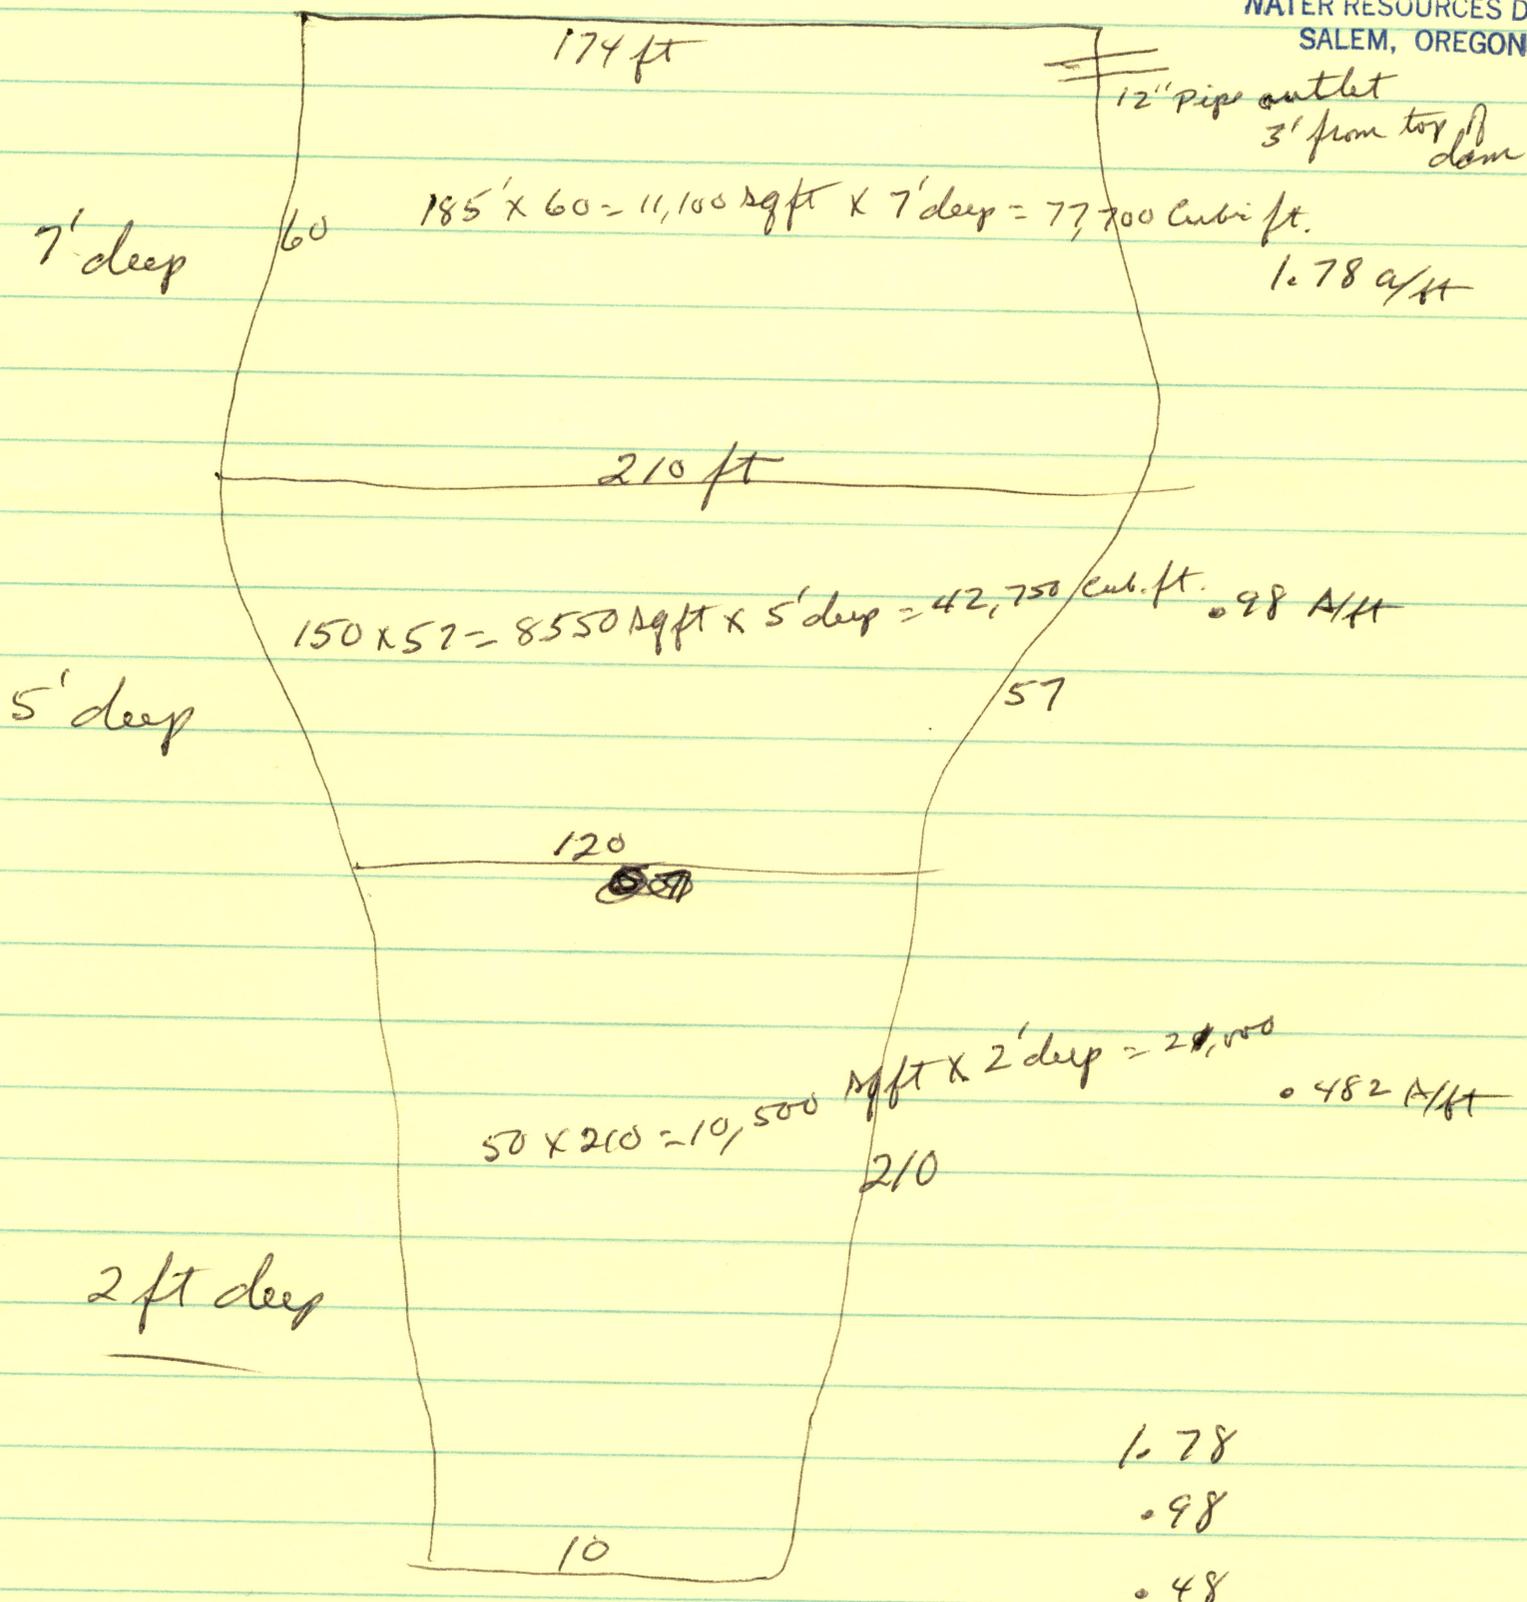

1.78  
0.98  
0.48

3.24 acre ft  
of water

Application No. P-77925  
Permit No.



Application No. P-77925

Permit No. \_\_\_\_\_

Name L ROBERT FORBES  
3760 ALTA VISTA RD

Address EAGLE POINT, OR 97524

Assigned \_\_\_\_\_

Address \_\_\_\_\_

Beginning construction \_\_\_\_\_

Completion of construction \_\_\_\_\_

Extended to \_\_\_\_\_

Complete application of water \_\_\_\_\_

Extended to \_\_\_\_\_