


14 13  
23 24

NW1/4, NW1/4

NE1/4, NW1/4

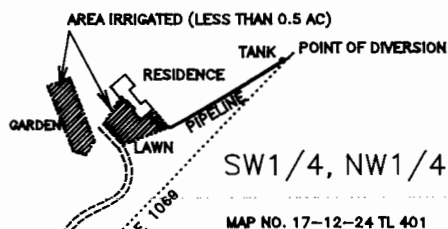

SE1/4, NW1/4

THIS MAP IS FOR THE PURPOSE  
OF IDENTIFYING THE LOCATION  
OF THE WATER RIGHT ONLY.  
THERE IS NO INTENT TO PROVIDE  
DIMENSIONS OR LOCATION OF  
PROPERTY OWNERSHIP LINES.

# FINAL PROOF WATER RIGHTS MAP

UNDER  
PERMIT 53032  
APPLICATION 80197

NW 1/4, SEC 23, T17S, R12W, W.M.  
LANE COUNTY, OREGON

FOR: RANDY AND SALLY CENTER  
90090 BEN BUNCH ROAD  
FLORENCE, OREGON 97439

MAP NO. 17-12-24 TL 401

PREPARED BY: WOBBE & ASSOCIATES, INC.  
510 KINGWOOD ST. / P.O. BOX 3093  
FLORENCE, OR 97439  
DATE: FEBRUARY 17, 1998

