


LEGEND

- Point of Diversion (POD)
- Water Main Line
- Place of Use (POU)
- Tax Lot
- Government Lot (GL)
- Watercourse
- Waterbody

Claim of Beneficial Use in the Name of Falcon Cove Water District Application S-52592, Permit S-37930

Clatsop and Tillamook County
Township 3, 4 North, Range 10, 11 West (W.M.)

CERTIFIED WATER RIGHTS EXAMINER STAMP

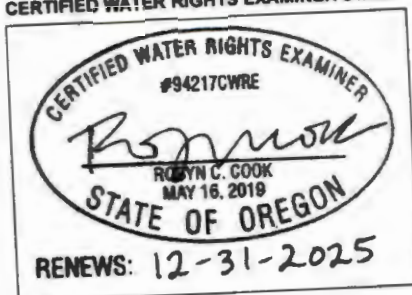

Received

JUL 29 2024

OWRD

LOCATION DESCRIPTION

POD 1: South Spring
Located 1292.6 feet South and 230.8 feet East from the NW corner of Section 06, Township 3 North, Range 10 West (W.M.)
Coordinates: 45.779539, -123.987050

DISCLAIMER

This map was prepared for the purpose of identifying the location of a water right only and it is not intended to provide legal dimensions or location of property ownership lines.

Date: May 4, 2023

Data Sources: BLM, ESRI, OWRD, USGS, DiamondMaps (2022)



0 660 1,320
1 inch = 1,320 feet

