


CLAIM OF BENEFICIAL USE SURVEY  
 PERMIT R88282 & S55109  
 T39S R3W S10 W.M.  
 ROGUE RIVER BASIN - JACKSON COUNTY, OR



SCALE 1 INCH = 400 FEET

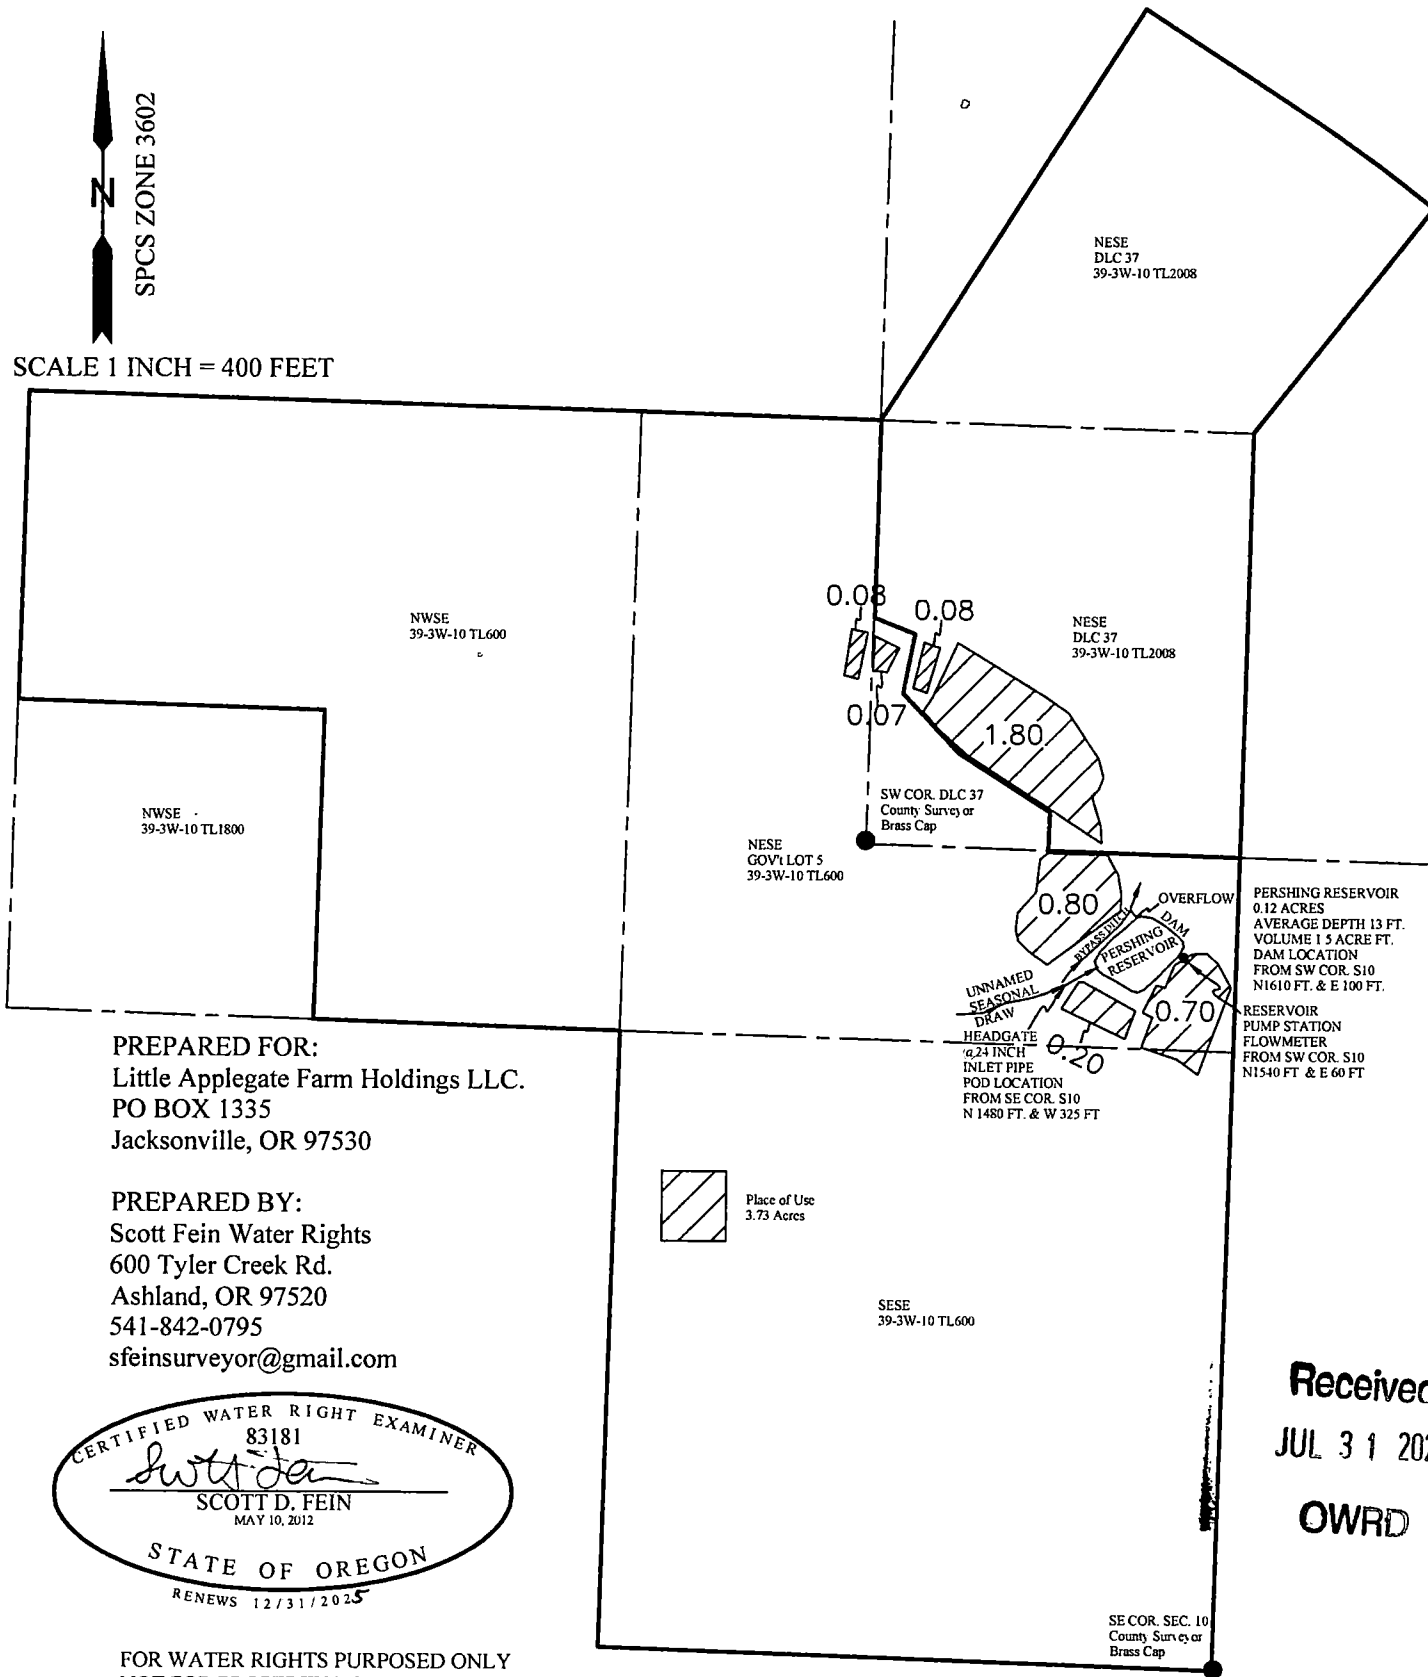

PREPARED FOR:  
 Little Applegate Farm Holdings LLC.  
 PO BOX 1335  
 Jacksonville, OR 97530

PREPARED BY:  
 Scott Fein Water Rights  
 600 Tyler Creek Rd.  
 Ashland, OR 97520  
 541-842-0795  
 sfeinsurveyor@gmail.com



FOR WATER RIGHTS PURPOSED ONLY  
 NOT FOR PROPERTY BOUNDARY  
 LOCATIONS OR DIMENSIONS  
 NO UNAUTHORIZED REPODUCTION OR MODIFICATION

**Received**  
 JUL 31 2024  
 OWRD