


T. 15 S., R. 5 W., W.M.

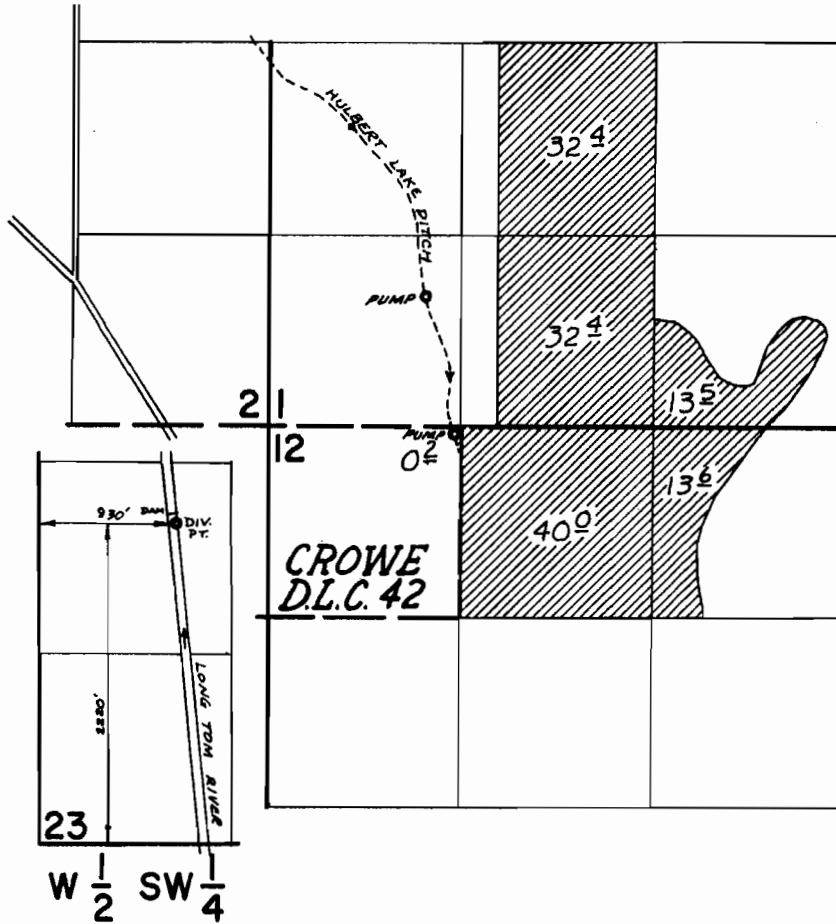

**FINAL PROOF SURVEY**  
UNDER

Application No. 47201 Permit No. 35702  
IN NAME OF

MRS. JESSIE TRACER PHILLIPS

Surveyed Sept 18 1973, by D. NORBY