


S1/2 SECTION 35, TWP.1 S. RANGE 24 E. &
N1/2 SECTION 2, TWP.2 S. RANGE 24 E. W.M.
MORROW COUNTY, OREGON

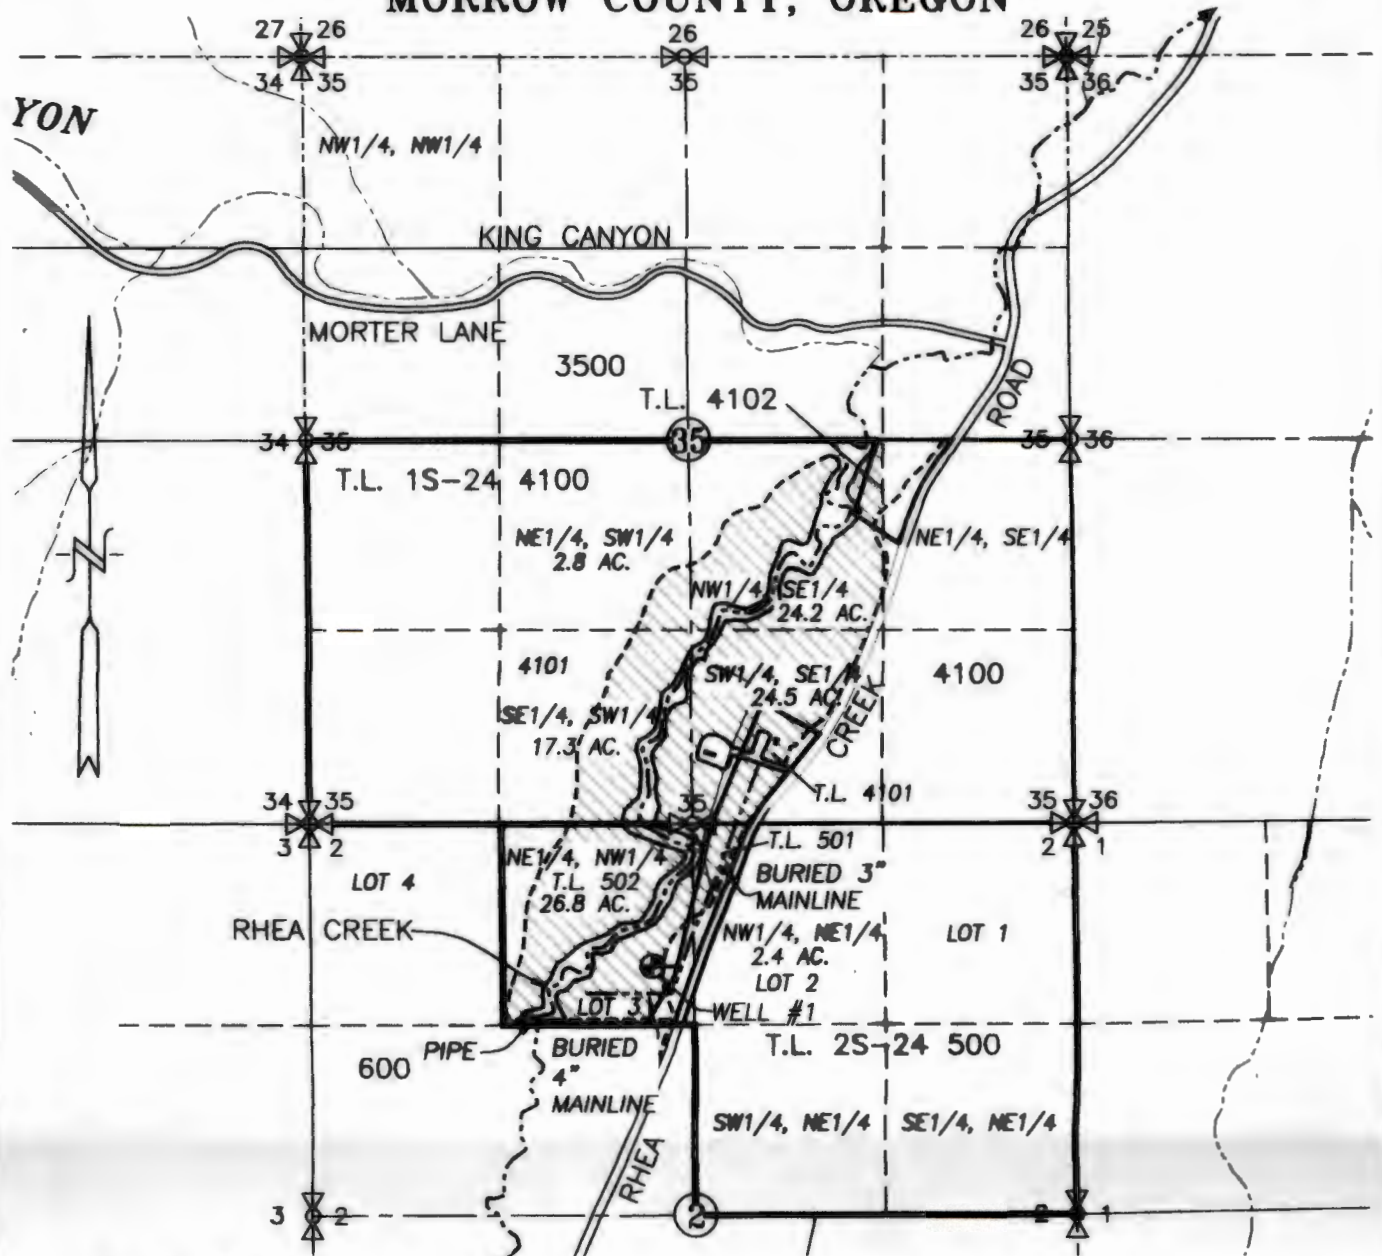

LEGEND:

● WELL & METER (MORR 35): 980' SOUTH AND 2,350' EAST FROM THE NW CORNER OF SECTION 2.

▨ APPLICATION AREA = 98.0 ACRES


— IRRIGATION MAIN

- - - DITCH

~ ~ ~ STREAM/DITCH WITH DIRECTIONAL FLOW

CLAIM OF BENEFICIAL USE MAP

SCALE: 1" = 1320'

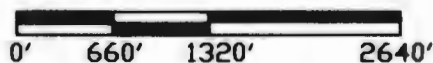

APPLICATION No. G-15478

PERMIT No. G-15220

IN THE NAME OF:

JOHN R. MURRAY & ANNE CATHERINE MURRAY
(BROTHER & SISTER)

DATE: JUNE 19, 2024

BY: **TENNESON ENGINEERING CORP.**

3775 CRATES WAY
THE DALLES, OREGON. 97058
PH. 541-296-9177
FAX 541-296-6657



NOTE:

"THIS MAP IS NOT INTENDED TO PROVIDE LEGAL DIMENSIONS OR LOCATIONS OF PROPERTY OWNERSHIP LINES."

Received

AUG 12 2024

OWRD



EXPIRES: 12/31/2025

W.O. #14633wr