

RECEIVED

JUN - 6 1997

WATER RESOURCES DEPT.
SALEM, OREGON

Oregon Water Resources Department
Commerce Building
158 12th Street NE
Salem, OR 97310-0210

Oregon

DEPARTMENT OF
FISH AND
WILDLIFE

Lake District Office

Re: Comments to Exempt Reservoirs

Applications: P-80874 Dumilleau, P-80688 Waterbury,
P-82958-1,2,3,4 Griffith, P-82927-1,2 Jaska, P-82780
Parmelee, P-82752-1,2,3,4,5,6,7,8,9 O'Keefe, P-82716 Robins,
P-82708 Liddycoat, P-82233 Cooper, P-82231 Gustine, P-81148
and P-81149 and P-81150 Williams, P-81180 Sommerville, P-
81504 Edwards, P-82073 and P-82072 Ogle, P81808 Evans.
Before any fish are stocked in these waters contact ODFW at
541-947-2950. Fish screens may be needed to protect native
stocks.



Application P-81777 Collins Pine. No stocking of fish unless
the outlet is fit with a fish screen.

Application P-81722 and P81723 Fremont Forest. Screen outlet
if feasible.

Application P-80963 Bach. A fish screen should be installed
at the point of diversion from Kelly Creek.

Sincerely,

Curtis Edwards

Curtis Edwards



PO Box 1214
Lakeview, OR 97630
(503) 947-2950

May 17, 1996

Oregon

DURELL WILLIAMS

HC 64 BOX 132
LAKEVIEW, OR 97630

WATER
RESOURCES
DEPARTMENT

REFERENCE: File # P-81148,P-81149,P-81150;

Notice of Exempt Reservoir (Pond)

This is to let you know that we have received your Notice of Exempt Reservoir and assigned it the number listed above. Please refer to this number if you need to contact us about the notice. As required by law, your Notice of Exempt Reservoir filing will appear in our weekly public notice within 90 days from the time it was filed.

We have determined that your reservoir appears to meet the general criteria for exemption from the requirement to obtain a permit. However, we feel it is important to tell you that the Department must accept comments until August 1, 1997 on whether the reservoir poses a threat to fishery resources or existing water right holders. After the August 1, 1997 deadline, the Department has 180 days to assess comments. Any such comments will be reviewed and you will be notified only if any action on your part is necessary.

If no comments are received or the Department's assessment shows your pond does not cause injury, your pond will be considered exempt. You are advised that this exemption is limited to the amount of water that had been stored prior to January 1, 1995. Any increase in the storage or use of the stored water after that date must be authorized under a permit issued by this Department.

If you have any questions, please write to use at the address below, or call the Water Rights Information Group at (503)378-8455 ext. 499 or toll free in Oregon, 1-800-624-3199 ext. 499.

Sincerely,



Anita McLoud
Water Rights Specialist
Water Rights Division

cc: Watermaster District 12



Commerce Building
158 12th Street NE
Salem, OR 97310-0210
(503) 378-3739
FAX (503) 378-8130



Oregon Water Resources Department Notice of Exempt Reservoir

For reservoirs built before January 1, 1995, that:

- Store less than 9.2 acre-feet of water, or
- Have a dam less than 10 feet high.

The deadline for submitting a Notice of Exempt Reservoir is January 31, 1997.

RECEIVED

APR 22 1996

WATER RESOURCES DEPT.
SALEM, OREGON

Landowner: Williams Durell
Last name First name MI
Authorized Agent: MI
Last name First name MI
Address: HC 64, Box 132
Lakeview OR 97630
City State Zip
Phone: (541) 947-4828
Home Work
FAX: Same E-Mail Address:

A. County of use: LAKE B. River basin (see reverse): 13

C. Legal description of reservoir location:

Township	Range	Section	Quarter/Quarter	Tax Lot #
SEE ATTACHMENT				

D. Name, if any, of reservoir: NONE E. Reservoir in existence since: / / See Attached letter
MM DD YY

F. Source of water: Runoff which flows into Cox/Bauers Cr.
Name of river or creek Name of river or creek

G. Maximum height of dam: See Attachment feet.

H. Quantity of water stored in reservoir at maximum capacity (see reverse): See Attachment acre-feet.

I. Water stored in reservoir is used for (see reverse): Stock water

J. Rate and area of use—Refer to chart on the back of this form. For each type of water use listed in Item I, show the quantity of water used and, if applicable, the number of acres on which water is used.

BEFORE YOU SIGN AND SUBMIT THIS APPLICATION... HAVE YOU:

- ☐ Answered each question on this form as completely as possible?
- ☐ Attached a legible map showing township, section, range, quarter-quarter & tax lot number?

By my signature below, I swear that all statements made and information provided in this application are true to the best of my knowledge.

Durell Williams Durell Williams 4-17-96
(Signature of Landowner/Agent) (Printed name and title) (Date)

For Department Use P-81148 4/22/96 10-95
File # Date received

881150

Water Resources Department
158 12th Street NE
Salem, Oregon 97310-0210

Application No. P-8114

SEC. 28

SEC. 21

TL 9100-3674-1


CANCELLED -NO

4501
2601
2801
2700
8500
8600
6601
6700
6701
6800
6900
1600
4200
4300
3400

SCALE 1:48000


APR 22 1996

WATER RESOURCES DEPT.

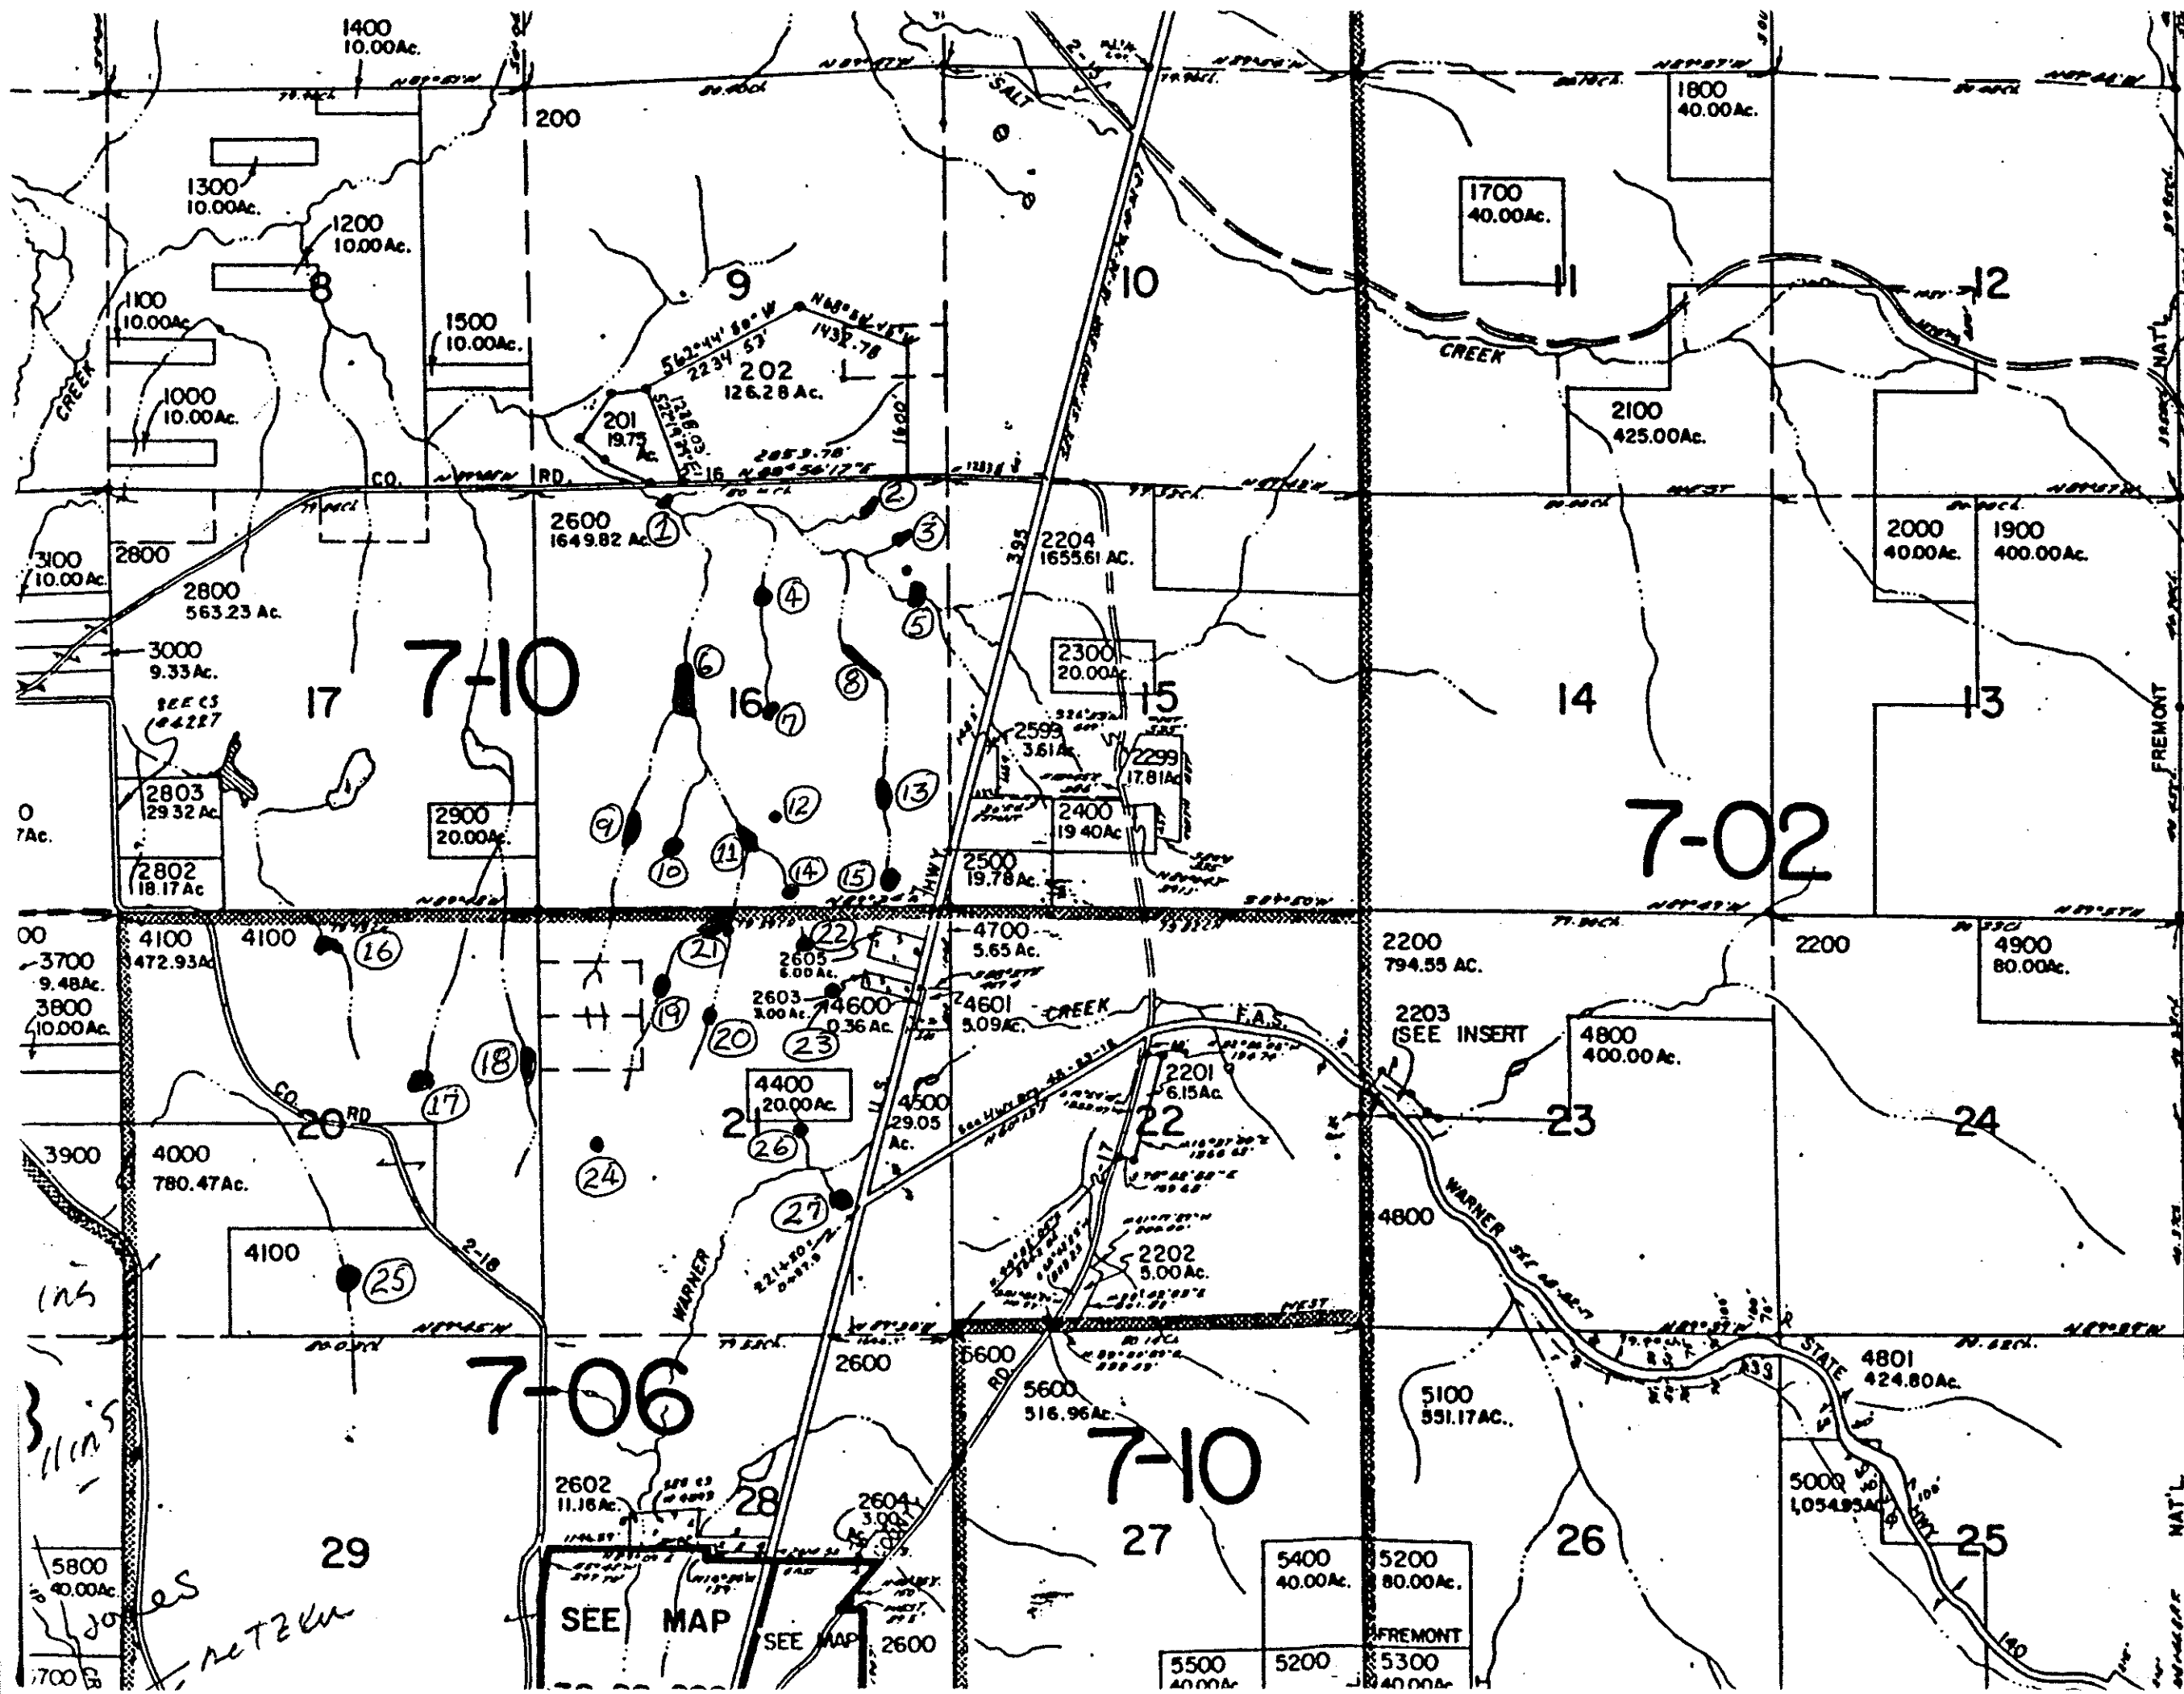

6700
6800
6900
1600
4200
4300
3400

SCALE 1:48000

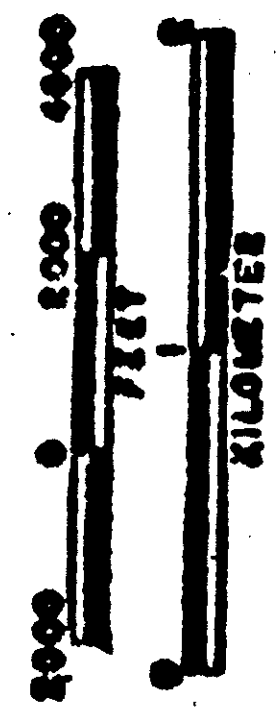

SEE MAP 38 21

Enlargement
of
map
38/20

FOREST
SECTION 28
PARCEL 2604
1. N 37° 34' 00" E 100.00' 100.00'
2. East 305.41'
3. S 89° 24' 00" W 305.41'
4. West 305.41'

Application N 281150
Permit N

RECEIVED

APR 22 1996

WATER RESOURCES DEPT.
SALEM, OREGONATTACHMENT

February 10, 1994

PONDS: all are located in Township 38 South, Range 20 East
of the Willamette Meridian

Pond Number	Height in feet	Capacity in acre ft.	Location	TAX LOT
1	7	2.5	NE 1/4 NW 1/4 Section 16	
2	9	1	NE 1/4 NE 1/4	"
3	7	0.3	"	"
4	6	0.3	NW 1/4 NE 1/4	"
5	9	3	SE 1/4 NE 1/4	" Water Right
6	9	5.6	SE 1/4 NW 1/4	"
7	7	0.5	NW 1/4 SE 1/4	"
8	9	2.5	SE 1/4 NE 1/4	"
9	7	0.4	SW 1/4 SW 1/4	"
10	8	0.4	SE 1/4 SW 1/4	"
11	9	3	"	"
12	5	0.1	SW 1/4 SE 1/4	"
13	5	0.3	NE 1/4 SE 1/4	"
14	6	0.3	SW 1/4 SE 1/4	"
15	4	0.1	SE 1/4 SE 1/4	"
16	9	4	NE 1/4 NW 1/4 Section 20	TAX LOT 4100
17	7	3	SE 1/4 NE 1/4	" 4100
18	9	3.5	"	" 4100
19	6	0.3	NW 1/4 NW 1/4 Section 21	TAX LOT
20	7	0.3	NE 1/4 NW 1/4	"
21	8	1	"	"
22	6	0.3	NW 1/4 NE 1/4	"
23	3	0.1	"	"
24	3	0.3	NW 1/4 SW 1/4	"
25	9	4	SW 1/4 SE 1/4 Section 20	TAX LOT 4100
26	6	0.3	NE 1/4 SW 1/4 Section 21	" " 2600
27	7	0.4	SE 1/4 SW 1/4	" " 2600
Total			37.8 Acre Feet	

16.5

PRE-TR APPLICATION PROCESSING OUTLINE

Application File # P- 81149

MINIMUM REQUIREMENTS TO FILE

OAR 690-11-020

H82376

DATE STAMP

DATE

INITIAL

5/10/96

[Signature]

Name and mailing address of applicant

Source of water

Quantity of water

Map showing location of POD & POU

Use of water

Names and addresses of legal owners

Signature of applicant

Oath

Application date stamped per money receipt date

Land use approved pending

If reservoir < 5 AF \$ if > 5 AF \$

HB 2153/HB 2107 APPLICATION -- SEE REVERSE

Route to Data Center (Unless 2153/2107)

DATA CENTER

Stream Code

Entered into WRIS

SUPPORT SERVICES

5/21/96

cn

Stamp contents with application number

Mail ack letter (provided by Data Center) with receipt to applicant, cc to CWRE and file

Place label on file and calender card

APPLICATION SECTION

Stream Indexed Basin #

Plat Carded and copy made YES NO

If dam is over 10 feet or storage exceeds 9.2

AC-FT, route file to Dam Safety Section

TR CASEWORKER

TR Checklist complete YES NO

Within Irrigation District

District Notified

District excerpt received

TR Mailed DATE

Public Interest Checklist complete

Management Codes

REMARKS:

MINIMUM APPLICATION REQUIREMENTS TO FILE:

HB 2153 - existing, small, EXEMPT ponds

(date & initials) NOTICE OF EXEMPT RESERVOIR form (or letter
if prior to April 8, 1994).

Appropriate map (see item 1 on form).

Evidence that reservoir existed before
January 1, 1993 (one or more of the following: dated aerial
photo, NOTARIZED affidavit, dated map from agency, construction
receipts or other documentation).

Items 2, 3, 4, 5, and 6 are completed.

Signature (and title, if applicable)

HB 2153 - non-exempt existing ponds (large, on-channel)

Complete Minimum Requirements to File on reverse, except before
routing to Data Center, change priority date to 1/1/1993. Also,
confirm the following:

Receipt of evidence that reservoir existed
before January 1, 1993 (one or more of the following: dated
aerial photo, NOTARIZED affidavit, dated map from agency,
construction receipts or other documentation)

**HB 2107 - wetland, stream restoration and storm water
management**

Complete Minimum Requirements to File on reverse EXCEPT DO NOT
ROUTE TO DATA CENTER, BUT DO ROUTE TO CAROL. Also confirm the
following:

within 1/4 mile Name/address of adjacent property owner

Map with scale not less than 2 in.=1 mi.

CWRE map if > 10 feet dam or > 9.2 AF

Description of proposed use

Condition addressed

Resulting benefits

Public notices (circle) #1 #2