


WASHINGTON COUNTY OREGON

SCALE 1" = 400'

R3W

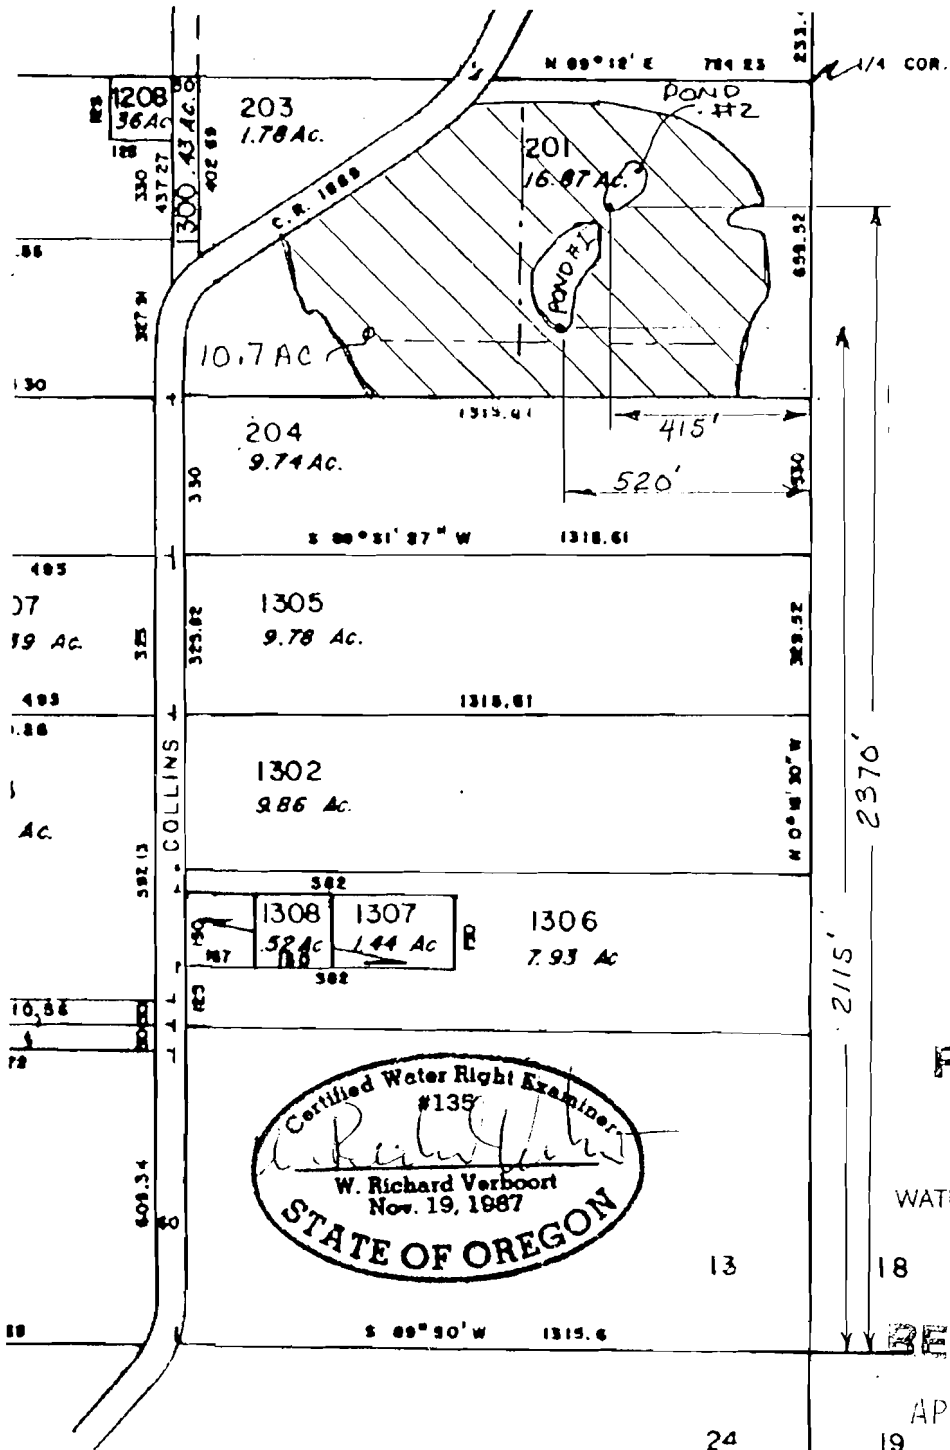

NORTH
T
Z
N

RECEIVED

MAY 01 2001

WATER RESOURCES DEPT.
SALEM, OREGON

RECEIVED

APR 09 2001

WATER RESOURCES DEPT.
SALEM, OREGON

VERBOORT ENGINEERING
AGRICULTURE • CIVIL • WATER RESOURCES
HILLSBORO, OREGON

by date
designed RV 10-00
drawn _____
checked _____
drawing no. 00-A-22
sheet no. 1/1

NED JAQUITH
1507 SE ALDER STREET
PORTLAND, OR 97214