



T.13S., R.30E., W.M.
CLAIM OF BENEFICIAL USE MAP
UNDER T-14169
 FOR
SHIRLEY AND GAIL ENRIGHT JOINT TRUST

Received by OWRD
 AUG 14 2024
 Salem, OR

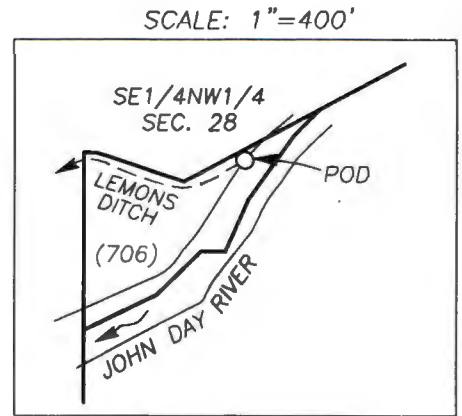

SCALE: 1" = 400'

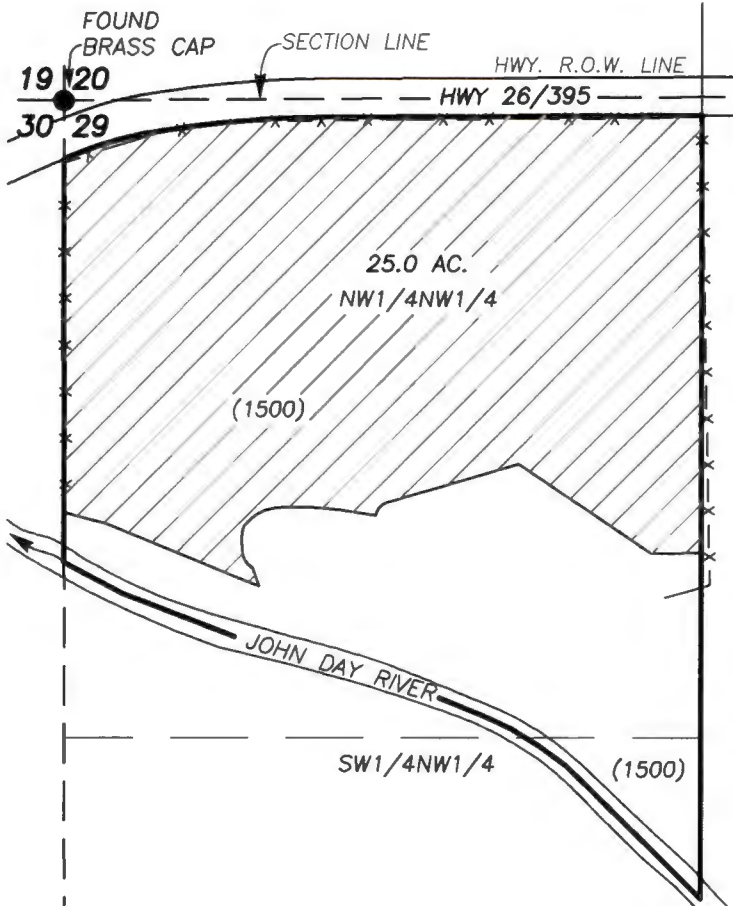

Received
 AUG 09 2024
 OWRD


O POD: 245 FT. NORTH & 955 FT. WEST FROM C1/4 COR. SEC. 28,
 T.13S., R.30E., W.M.
 FROM POD: ODFW FISH SCREEN AND FISH BYPASS STRUCTURE BEARS,
 S.65°W., 150 FT.
 MEASUREING DEVICE AND STAFF GUAGE BEARS, S74°W., 250 FT.

PREPARED BY:
 ROBERT D. BAGETT, PLS, CWRE
 217 N. CANYON BLVD.
 JOHN DAY, OREGON
 (541) 575-1251
 AUGUST 1, 2024

PLACE OF USE: PRIMARY (1911) / SUPPLEMENTAL (1981)

() TAX LOT NO.

X—X FENCE LINE

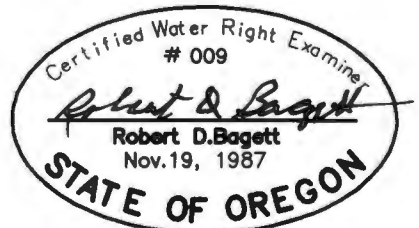

EXPIRES 12/31/2025

DISCLAIMER: THIS MAP IS NOT INTENDED TO PROVIDE LEGAL DIMENSIONS OR LOCATIONS OF PROPERTY OWNERSHIP LINES.