

6
7
T18 S.R. 5 W.W.M.
LAKE COUNTY, OREGON

FINAL PROOF SURVEY

UNDER ⁶⁶⁶ 72734 ⁶⁶⁶

APPLICATION NO. R-72736 PERMIT NO. R-11544

IN NAME OF

LINDA KOHRADY

SURVEYED APRIL 3, 1997 BY: CHARLES W. GUILLE

RECEIVED

MAY 19 1997

WATER RESOURCES DEPT.
SALEM, OREGON

PRIORITY DATE


SEPT. 28, 1992

THIS MAP IS FOR WATER RIGHT
PURPOSE ONLY AND IS NOT
INTENDED TO PROVIDE
DIMENSIONS FOR LOCATING
PROPERTY BOUNDARIES

LOCAL POINT OF DIVERSION
IS 2845.0 FEET SOUTH AND
145.0 FEET EAST OF THE
NORTH 1/4 OF SEC. 7 T.18
S.R. 5 W.W.M.



SCALE 1" = 400'

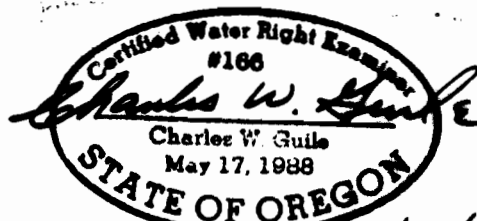

EXP DATE 6/30/97

CHARLES W. GUILLE
& ASSOCIATES, CO.
Land Surveying
52 Centennial Loop
Eugene, OR 97401

92-67

