
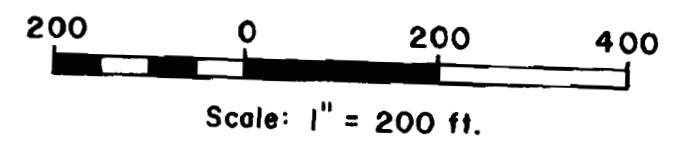


RECEIVED

SEP 28 2000

WATER RESOURCES DEPT.  
SALEM, OREGON

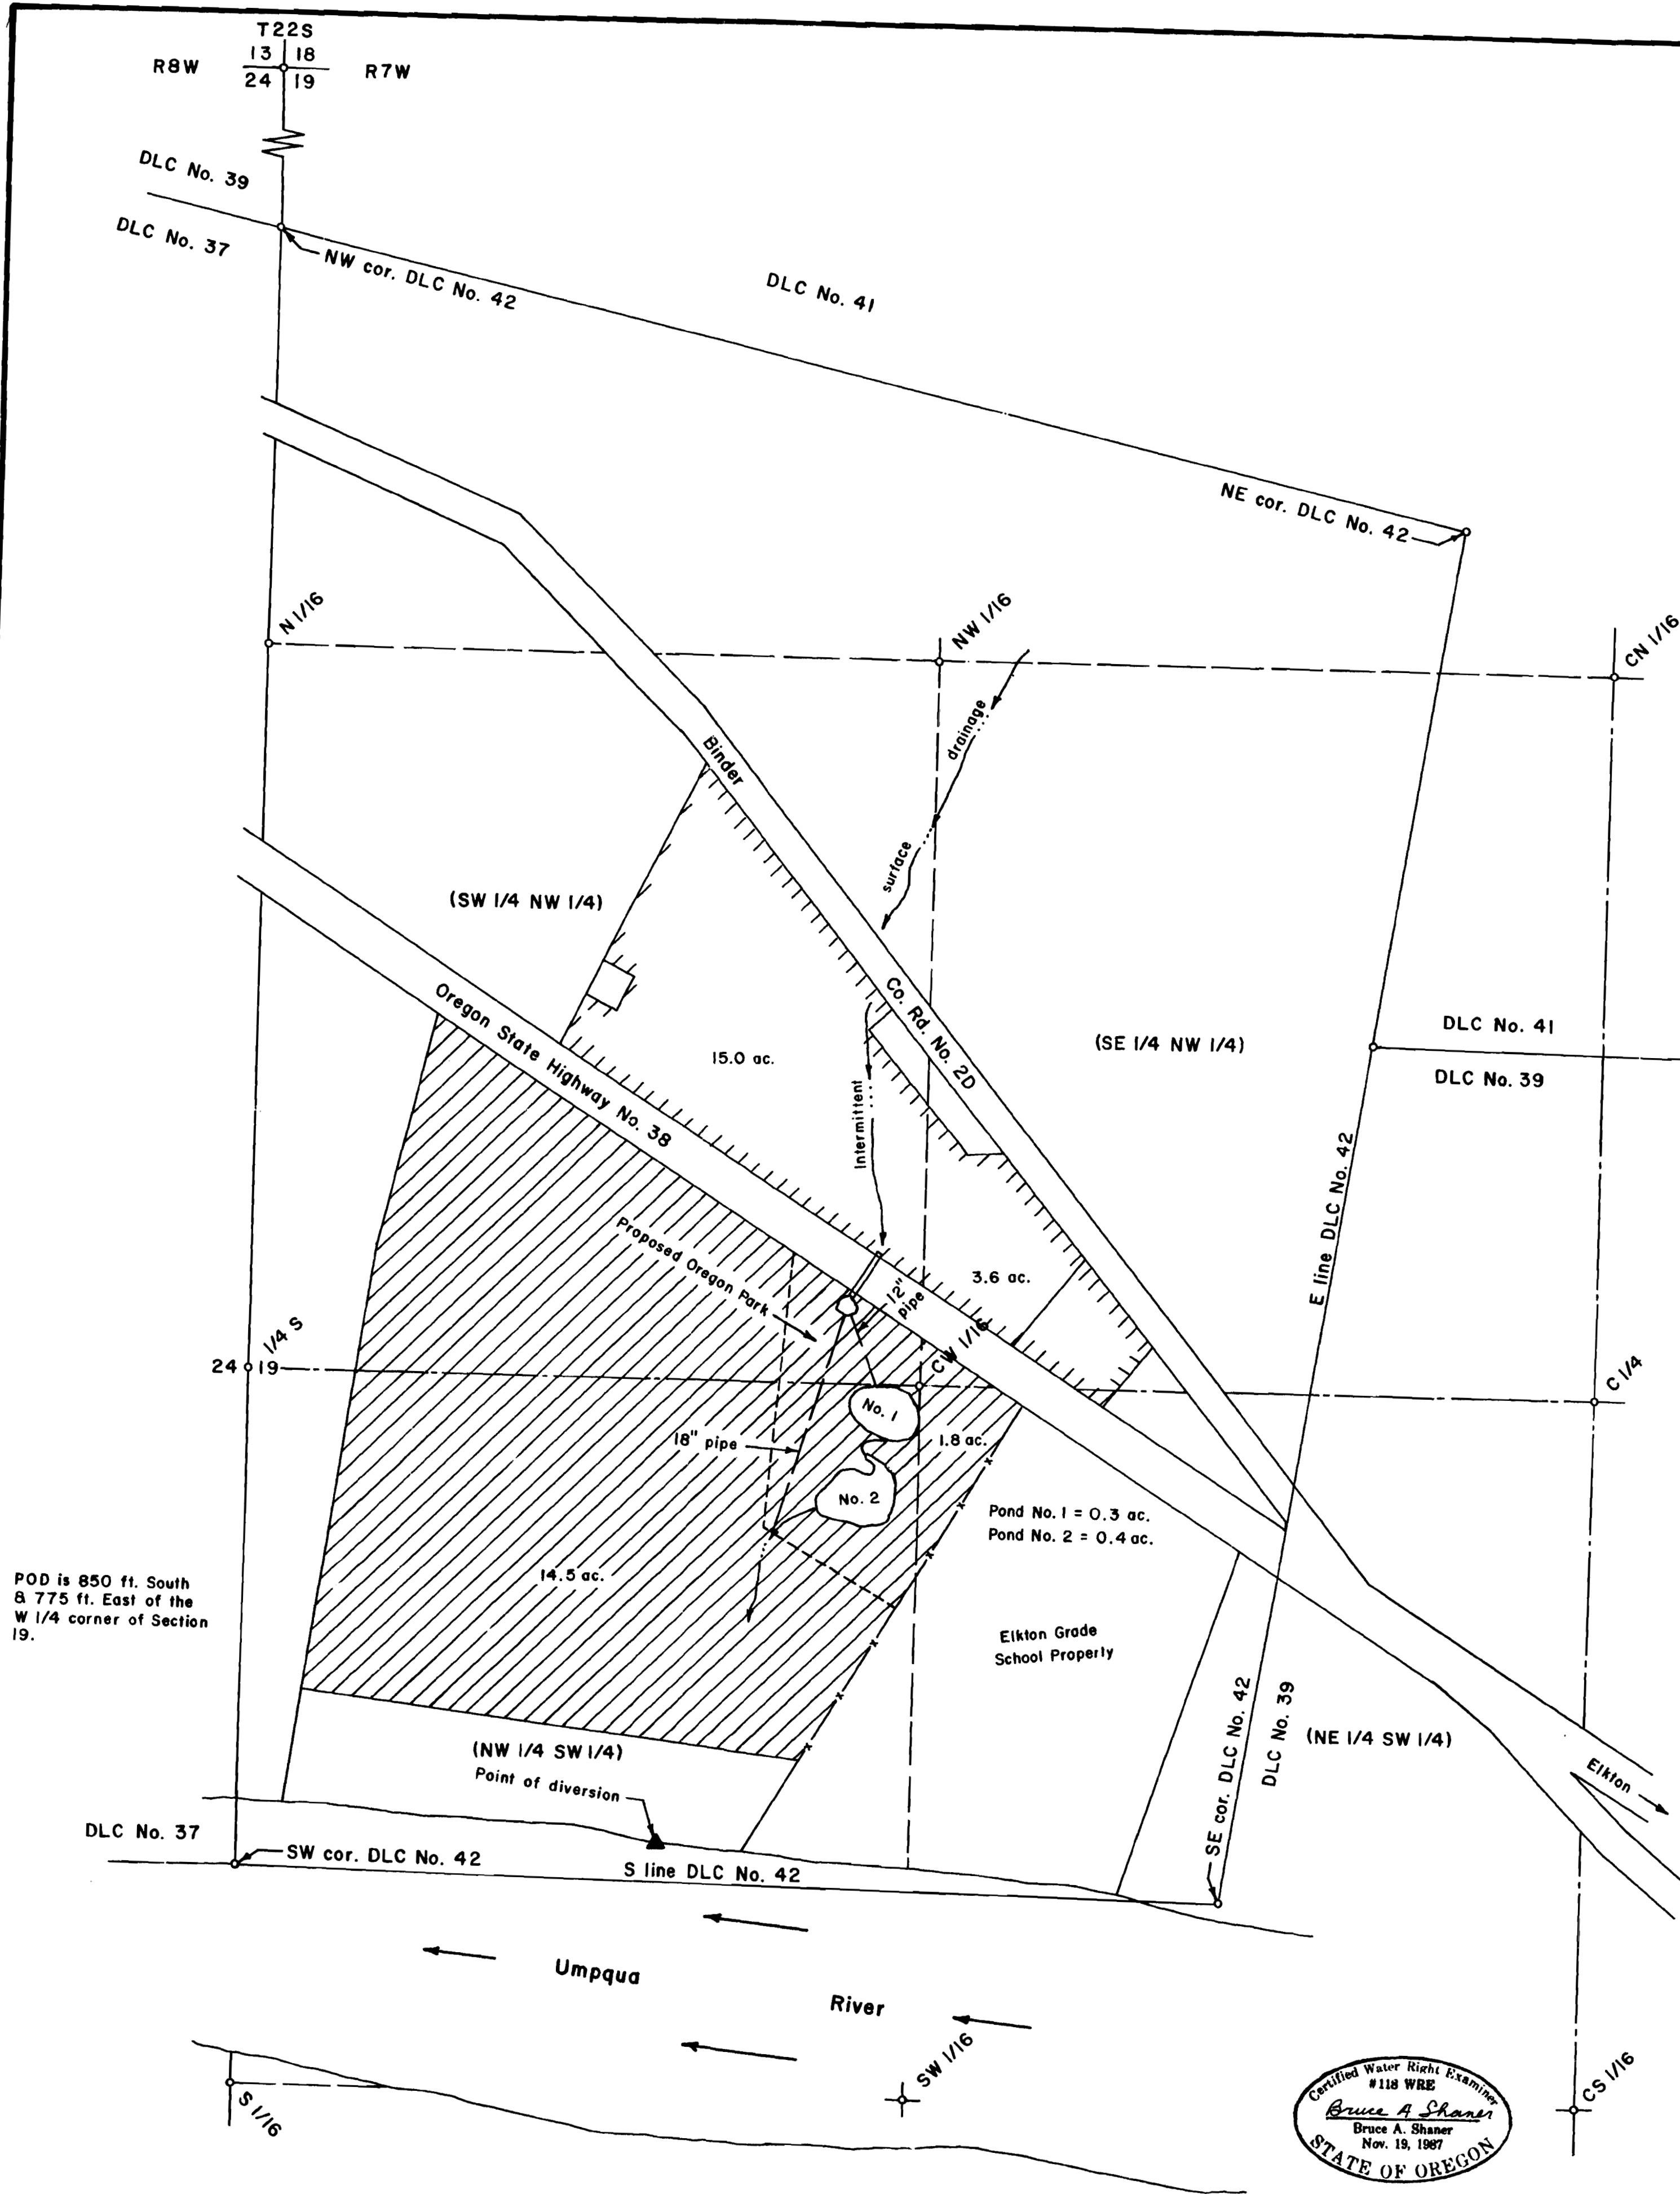

**PERMIT TO STORE SURFACE WATER**  
 in the H. B. Harts DLC No. 42 and in the  
 W 1/2 of Section 19, T22S, R7W, W.M.,  
 Douglas County, Oregon

Water Right Certificate No. 22347 in the name of Oliver  
 Haines, Elkton, Oregon (existing)

Application No.

Permit No.

For: Carol Beckley  
 P.O. Box 480  
 Elkton, Oregon 97436

By: Shaner Engineering, Inc.  
 P.O. Box 1430  
 Roseburg, Oregon 97470

