


FINAL PROOF SURVEY MAP  
IN THE NAME OF BLAKE OR RACHEL BAIRD  
SECTION 9, TOWNSHIP 24, SOUTH, RANGE 6 WEST, W.M.  
APPLICATION R-80569 PERMIT R-12018

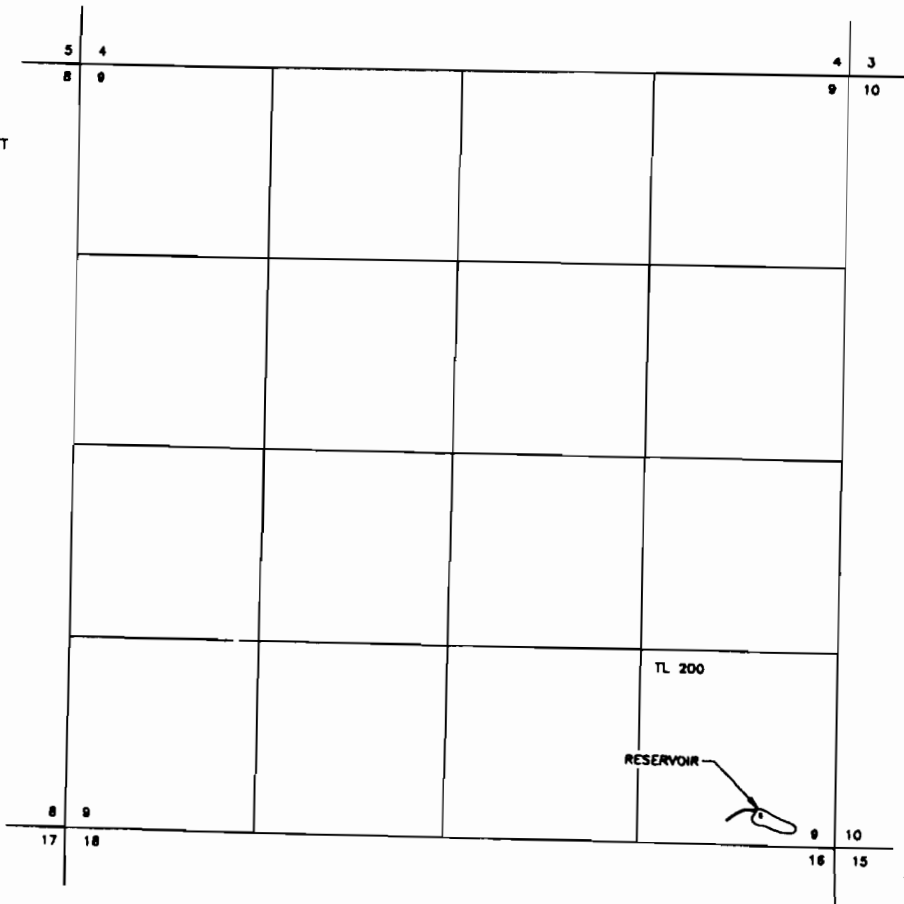

THE RESERVOIR IS LOCATED 150 FEET NORTH AND 400 FEET WEST FROM THE SOUTHEAST CORNER OF SECTION 9, BEING WITHIN THE SE 1/4 SE 1/4 OF SECTION 9, TOWNSHIP 24 SOUTH, RANGE 6 WEST, W.M., DOUGLAS COUNTY.

THE PURPOSE OF THIS MAP IS TO IDENTIFY THE LOCATION OF THE WATER RIGHT. IT IS NOT INTENDED TO PROVIDE INFORMATION RELATIVE TO THE LOCATION OF PROPERTY OWNERSHIP BOUNDARY LINES.