



T.4 | S., R.1E., W.M.
JACKSON Co., OR.

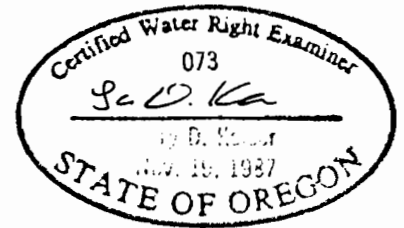

Application No. 72269
Permit No. R12613

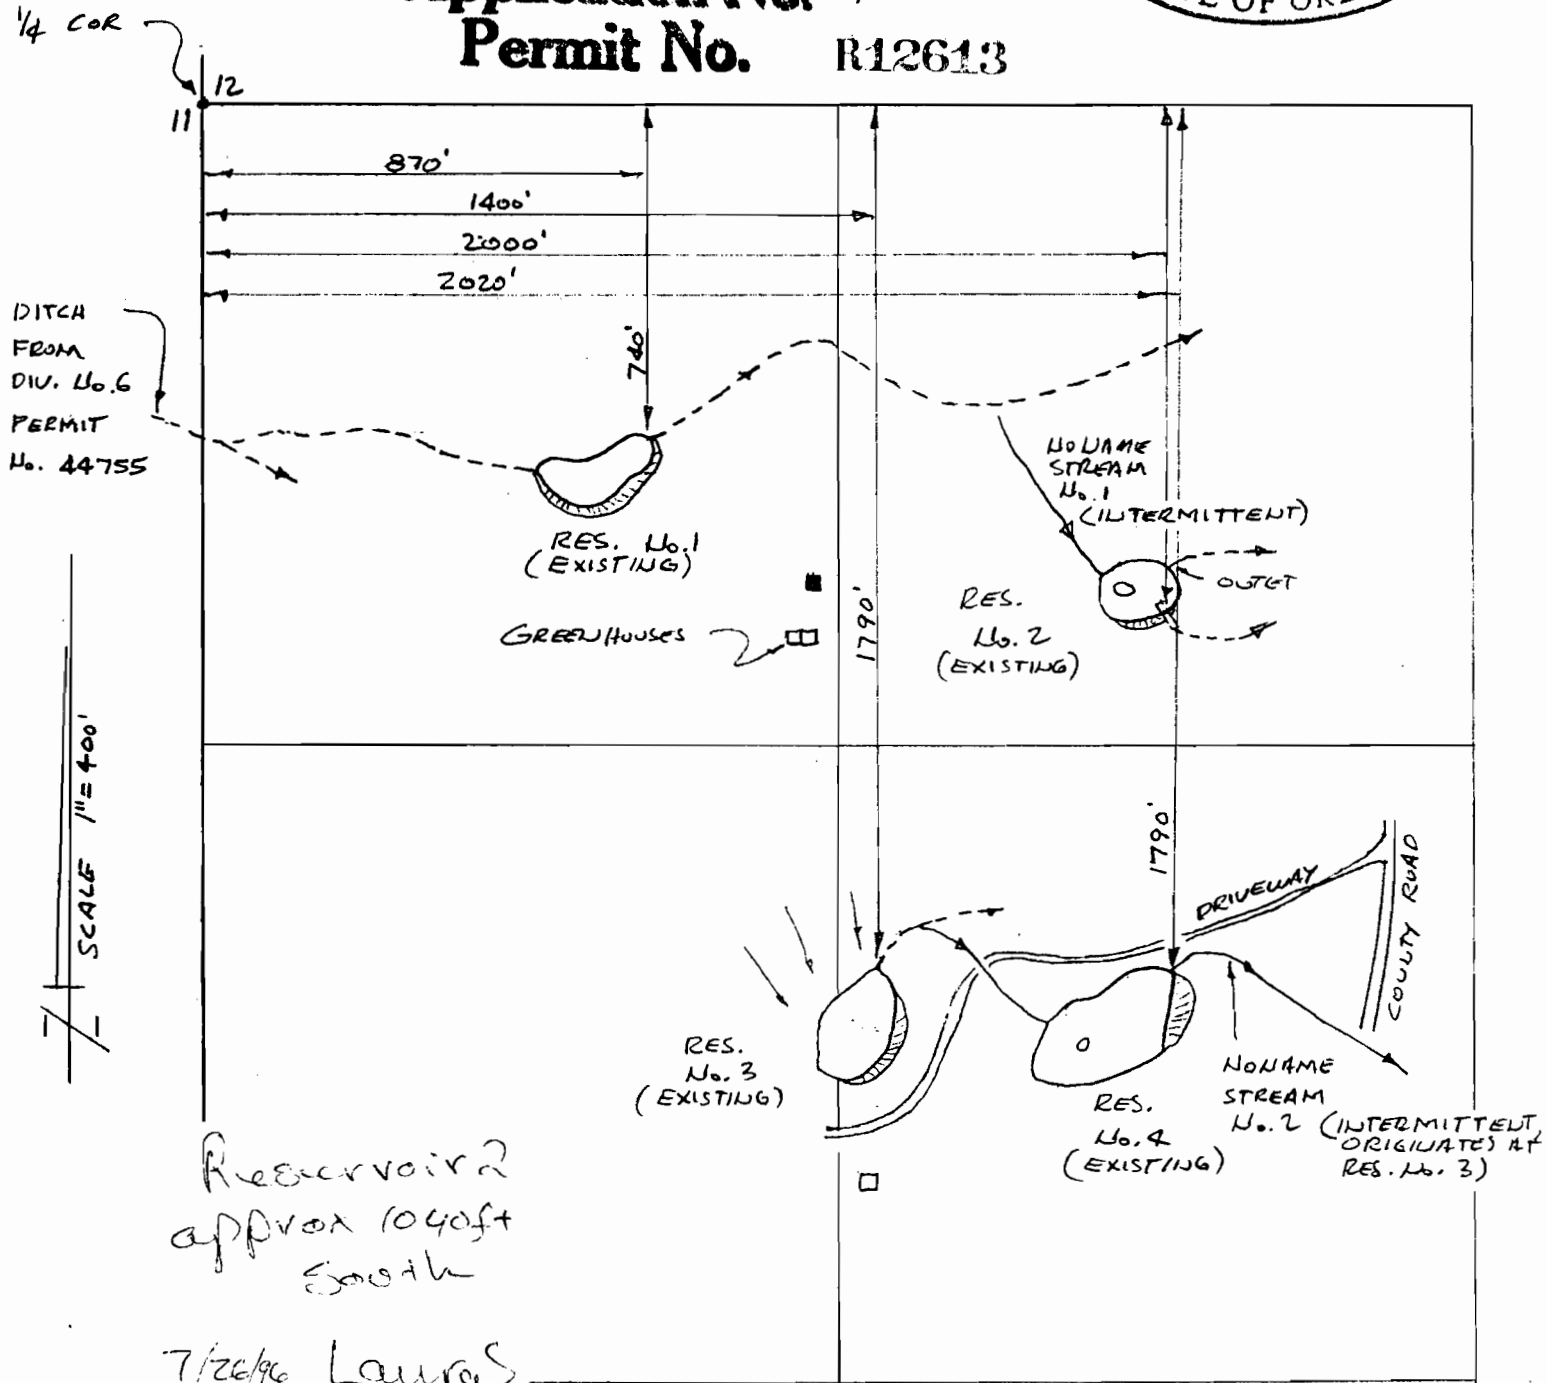

MAP TO ACCOMPANY AN APPLICATION FOR A PERMIT TO CONSTRUCT 4 RESERVOIRS TO BE USED FOR SUPPLEMENTAL IRRIGATION TO THE FUJAS PROPERTY UNDER PERMIT No. 44755 AND FOR OUT-OF-SEASON IRRIGATION IN A GREENHOUSE. MAP ALSO ACCOMPANYS APPLICATION FOR

PREPARED FOR:
RICHARD FUJAS
5126 PACIFIC Hwy.
PHOENIX, OR 97535

PREPARED BY:
KAISER SURVEYING
19440 Hwy. 62
EAGLE POINT, OR 97524

NOTE: MAP PREPARED FOR WATER RIGHT PURPOSES ONLY, NOT FOR PROPERTY BOUNDARY LOCATIONS

FEBRUARY 5, 1992