


SECTIONS 1, 2, 11 AND 12, TOWNSHIP 5 S. RANGE 15 E. W.M.
WASCO COUNTY, OREGON

**CLAIM OF BENEFICIAL
USE MAP**

SCALE: 1" = 1320'

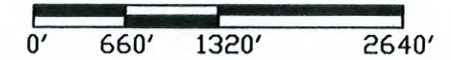

- NEW WELL (1,580' NORTH AND 310' WEST)
- MAIN WELL (1040' NORTH AND 705' WEST)

ALL FROM THE SECTION CORNER 1,2,11,12

LAND IRRIGATED - 98.9 ACRES

RESERVOIRS

PIPELINE

TRANSFER No. _____

APPLICATION No. G-16492

PERMIT No. G-16127

IN THE NAME OF:
A & K RANCHES

DATE: JULY 22, 2024

Received
AUG 16 2024
OWRD



EXPIRES: 12/31/2025

NOTE:

"THIS MAP IS NOT INTENDED TO PROVIDE LEGAL DIMENSIONS OR LOCATIONS OF PROPERTY OWNERSHIP LINES."

TENNESON ENGINEERING | AN AKS COMPANY
3775 CRATES WAY
THE DALLES, OR 97058
541.296.9177
WWW.AKS-ENG.COM



ENGINEERING · SURVEYING · NATURAL RESOURCES
FORESTRY · PLANNING · LANDSCAPE ARCHITECTURE

