

Request for Assignment

OREGON



WATER RESOURCES
DEPARTMENT

Oregon Water Resources Department
725 Summer Street NE, Suite A
Salem, Oregon 97301-1266
(503) 986-0900
www.oregon.gov/owrd

If the Department determines that the application is incomplete, fees have not been paid, or the required documents are not acceptable, the application and all fees submitted will be returned to the applicant.

If for multiple rights, a separate form and fee for each right will be required.

I, Arriola Bogs, LLC

(Name of Current Holder of Record)

PO Box 1200

(Mailing Address)

Bandon

(City)

OR

(State)

97411

(Zip)

541-290-7634

(Phone #)

- hereby assign all my interest in and to the entire application/permit/transfer order/limited license/groundwater statement; (example, sold all the land authorized under the right)
- hereby assign all my interest in and to a portion of application/permit/transfer order/limited license/groundwater statement; (You must include a map showing the portion of the application/permit/transfer order/limited license/groundwater statement to be assigned. Example, sold a portion of the land authorized under the right)
- hereby assign a portion of my interest in and to the entire application/permit/transfer order/limited license/groundwater statement; (example, adding an additional person)

Application # S-74012 ; Permit # S-52994 ; Transfer Order # _____ ;

Limited License # _____ ; Groundwater Statement # _____ ;

as filed in the office of the Water Resources Director, to:

McKenzie Family Properties, LLC

(Name of New Owner)

92129 McKenzie Road

(Mailing Address)

Sixes

(City)

OR

(State)

97476

(Zip)

541-297-6534

(Phone #)

AgWest Farm Credit FLCA

(Name of New Owner)

2222 NW Kline Street

(Mailing Address)

Roseburg

(City)

OR

(State)

97471

(Zip)

(Phone #)

Note: If there are other owners of the property described in the application, permit, transfer order, limited license, or groundwater statement, you must provide a list of all other owners' names and mailing addresses and attach it to this form. Write the initials (first letters) of your first and last names at the spot indicated below.

JMB I hereby certify that I have notified all other owners of the property described in this application, permit, transfer order, limited license, or groundwater statement of this Request of Assignment.

Witness my hand this 24 day of June, 2024.

(Day)

(Month)

(Year)

Signature of Current Holder of Record

Shirley Arriola

Failure to provide any of the required information will result in the return of your application.

This certifies assignment and record change at Oregon Water Resources Department effective 8:00 a.m. on date of receipt at Salem, Oregon.

Fee receipt # 143395
For Director by Mary Bjork, Program Analyst in Water Rights Division. MJB

The completed "Request for Assignment" form *must* be submitted to the Department along with the recording fee of \$120.

Received

JUL 25 2024

OWRD

Part Assign - Approve
MJB 7-31-2024

RECEIVED

MAY 13 1999


WATER RESOURCES DEPT.
SALEM, OREGON

APPLICATION MAP

IN THE NAME OF SCOTT H. MC KENZIE

SECTIONS 29 & 32, T 31 S, R 15 W, W.M.

Arriola Bogs, LLC is assigning its portion of Permit S-52994 (as amended by T-8138), being 25.0 acres of cranberry operations in the NWNW of Section 32, to McKenzie Family Properties, LLC and AgWest Farm Credit FLCA

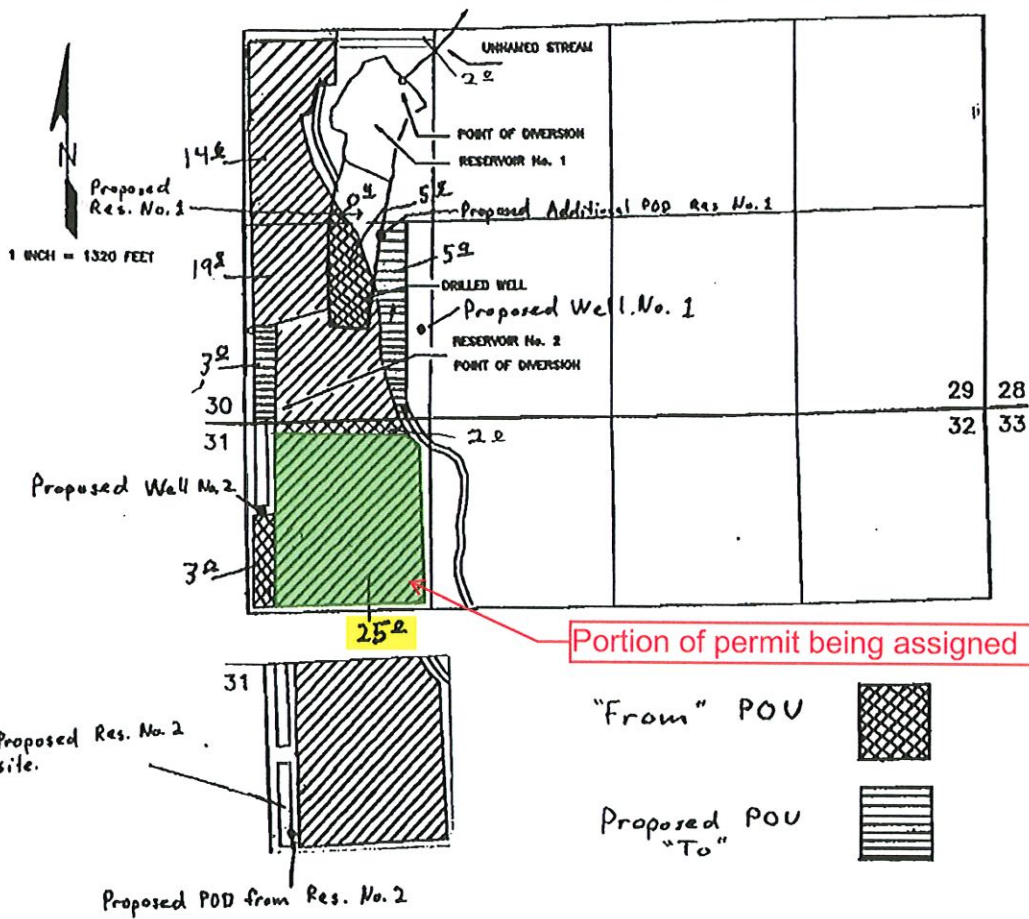

COPY

Received
JUL 25 2024
OWRD