


Groundwater Application - Vang

Township 5S, Range 2E, W.M.

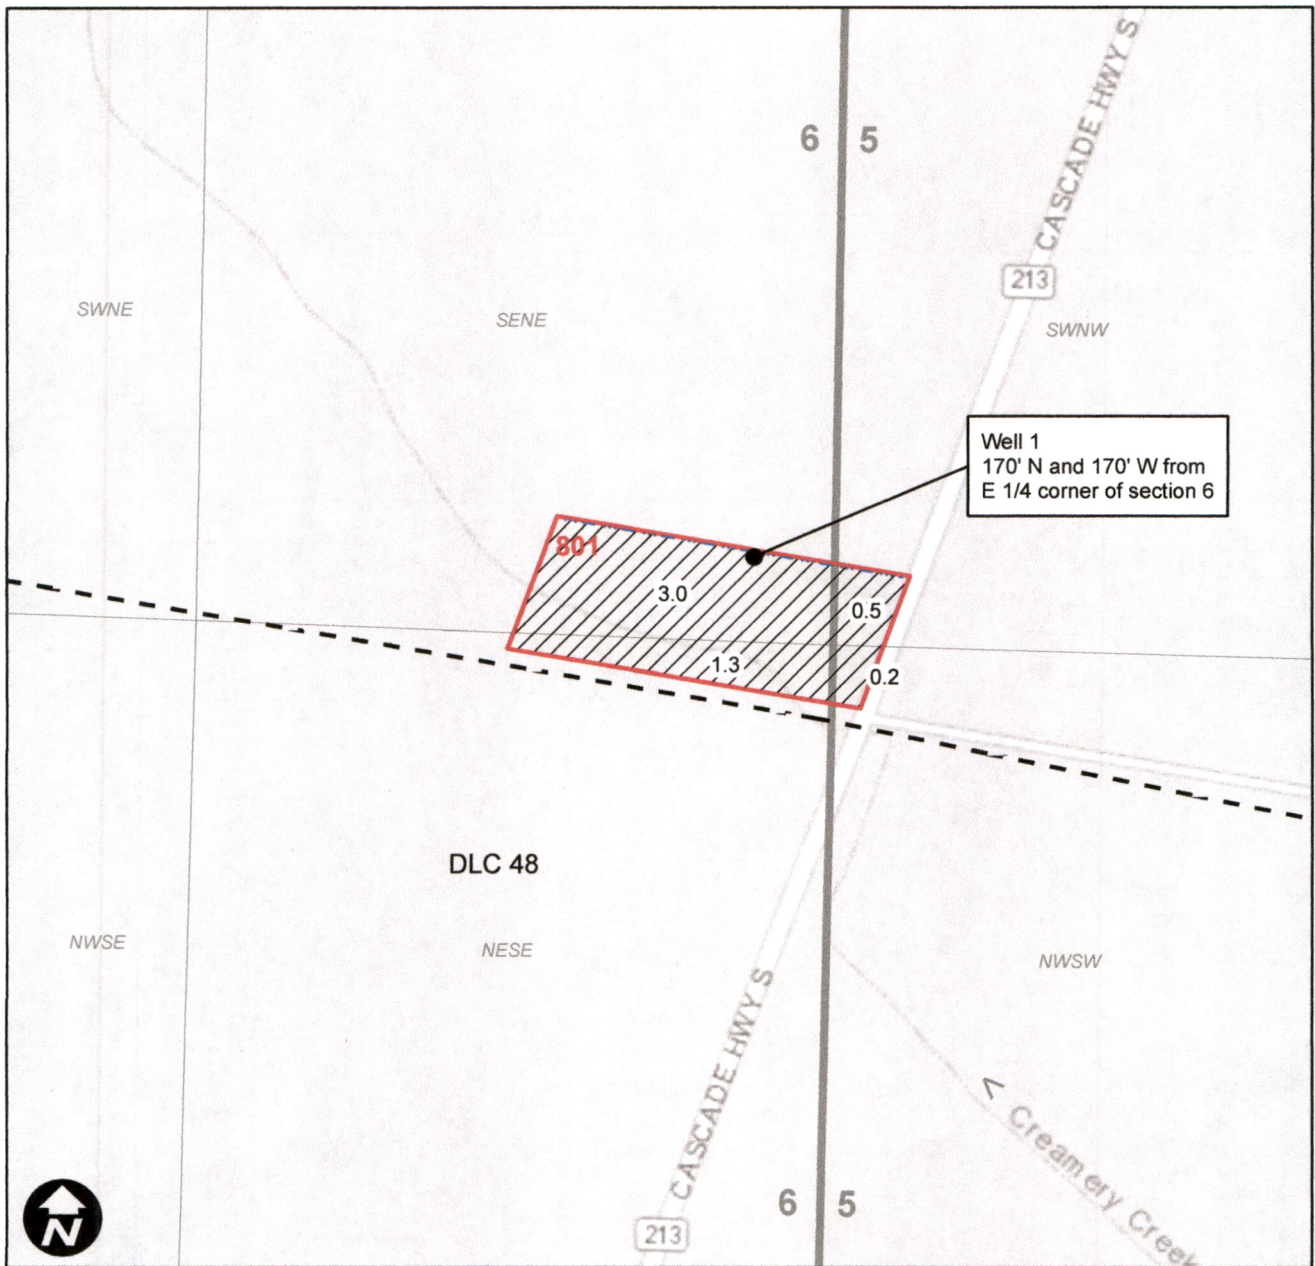

Legend

- NU POU
- Taxlot
- Mainline
- DLC

Received by OWRD

AUG 20 2024

Salem, OR