Application No R-85008
Permit No. R-13174

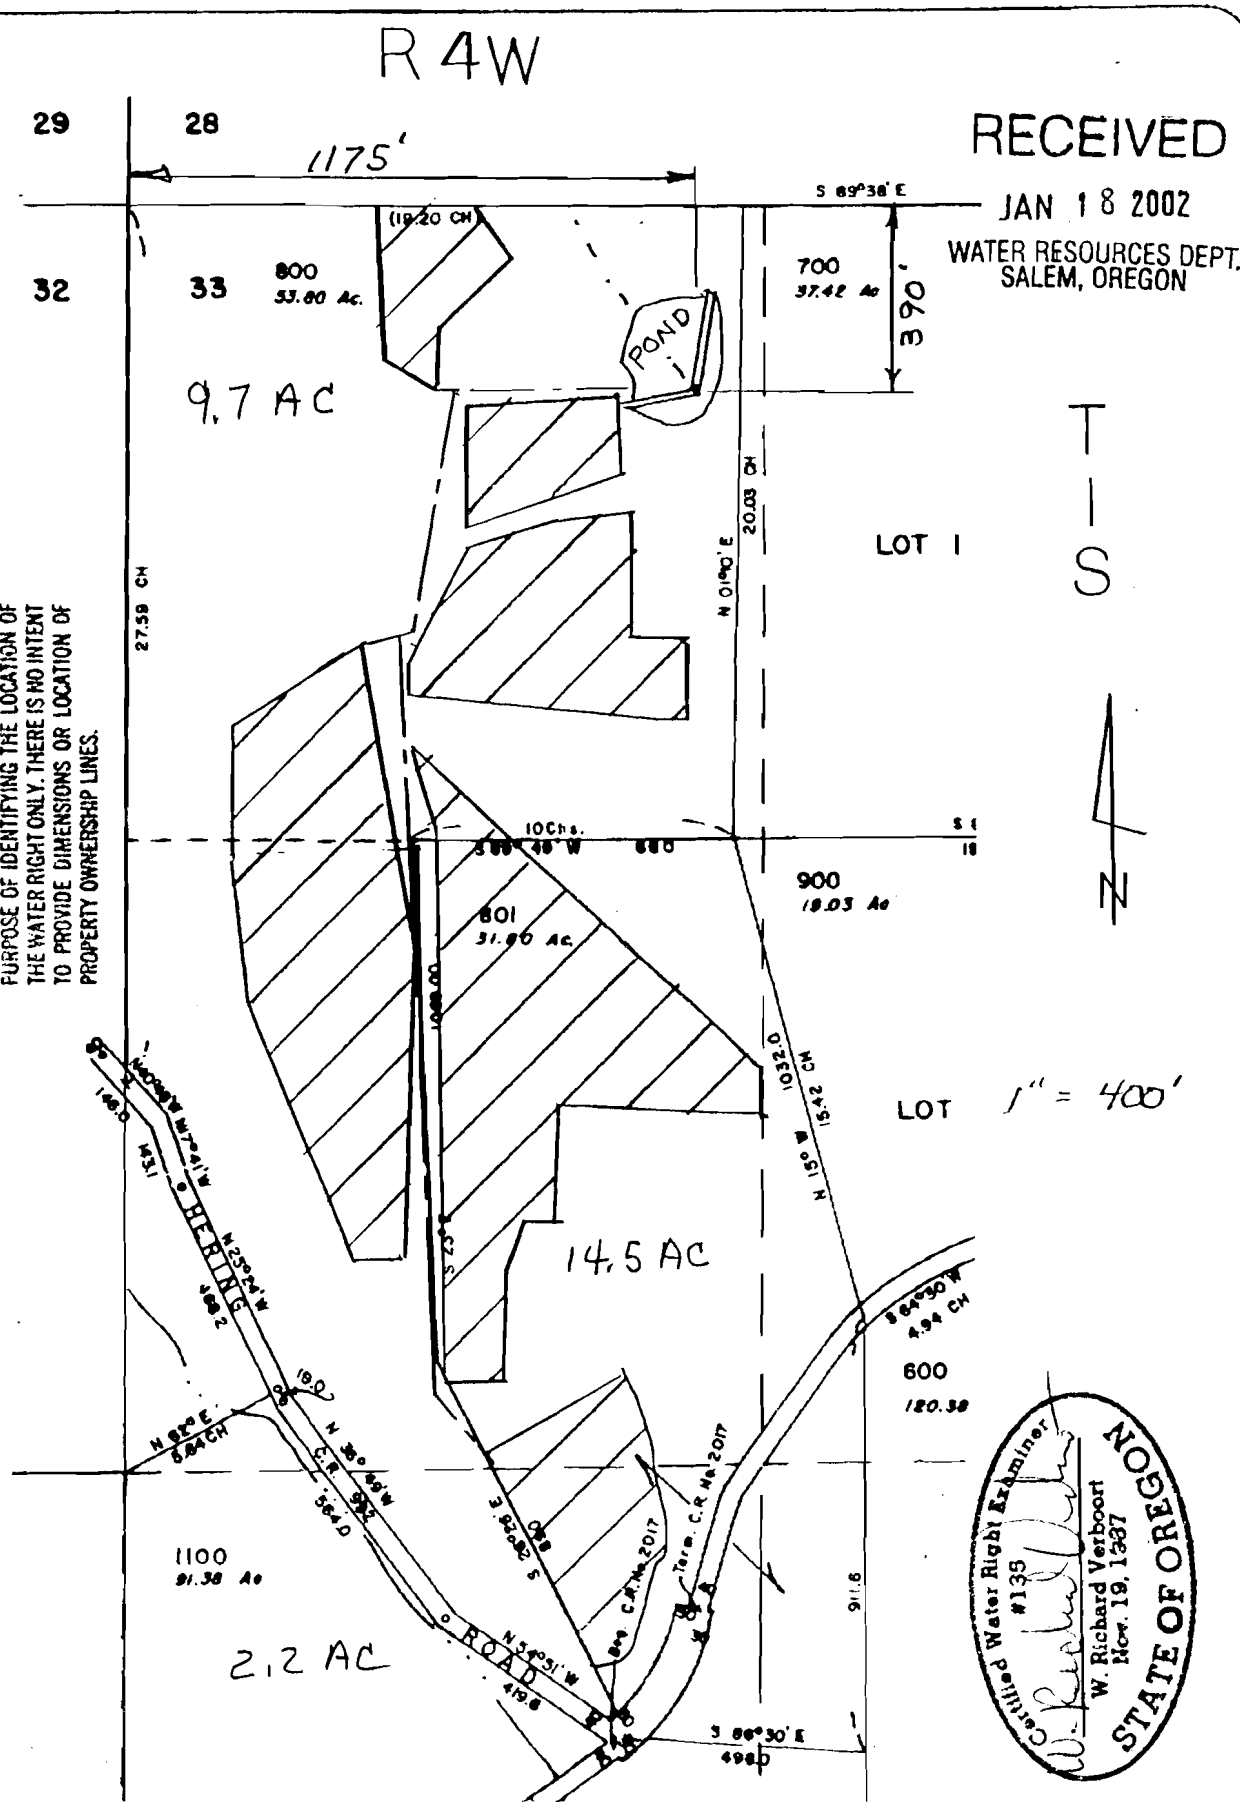

RECEIVED
JAN 18 2002
WATER RESOURCES DEPT.
SALEM, OREGON

VERBOORT ENGINEERING
AGRICULTURE · CIVIL · WATER RESOURCES
HILLSBORO, OREGON

	by	date
designed	RV	01/02
drawn		
checked	RV	01/02
drawing no.	02-A-01	
sheet no.	1/1	

CHERRY GROVE VINEYARDS, LLC
12122 TRAIL END ROAD
LEANDER TX 78641
ATT: Mr. Robert Van Steenberg