

CLAIM OF BENEFICIAL USE MAP

T-12217
 SECTIONS 21, 22, 27, & 28, TOWNSHIP 16 SOUTH, RANGE 21 EAST
 SECTION 4, TOWNSHIP 17 SOUTH, RANGE 21 EAST
 WILLAMETTE MERIDIAN, CROOK COUNTY, OREGON
 JULY, 2024

Received by OWRD

AUG 26 2024

Salem, OR



EXPIRES 12/31/2024


Received by OWRD

AUG 26 2024

Salem, OR

- LEDGEND**
- POINTS OF APPROPRIATION
 - EXISTING FISH SCREENS
 - EXISTING PUMP STATION & METER
 - EXISTING IRRIGATION DITCH
 - NORTH FORK CROOKED RIVER
 - COMMITTEE CREEK
 - EXISTING PIPELINE
 - PLACE OF USE PERMIT C-606
40 ACRES, PRIORITY DATE 1882
 - PLACE OF USE PERMIT C-606
30 ACRES, PRIORITY DATE 1895
 - PLACE OF USE PERMIT C-606
41 ACRES, PRIORITY DATE 1898
 - PLACE OF USE PERMIT C51366
51.8 ACRES, PRIORITY DATE 1960

SCALE: 1" = 1320'
 FOR 11"x17" SHEETS

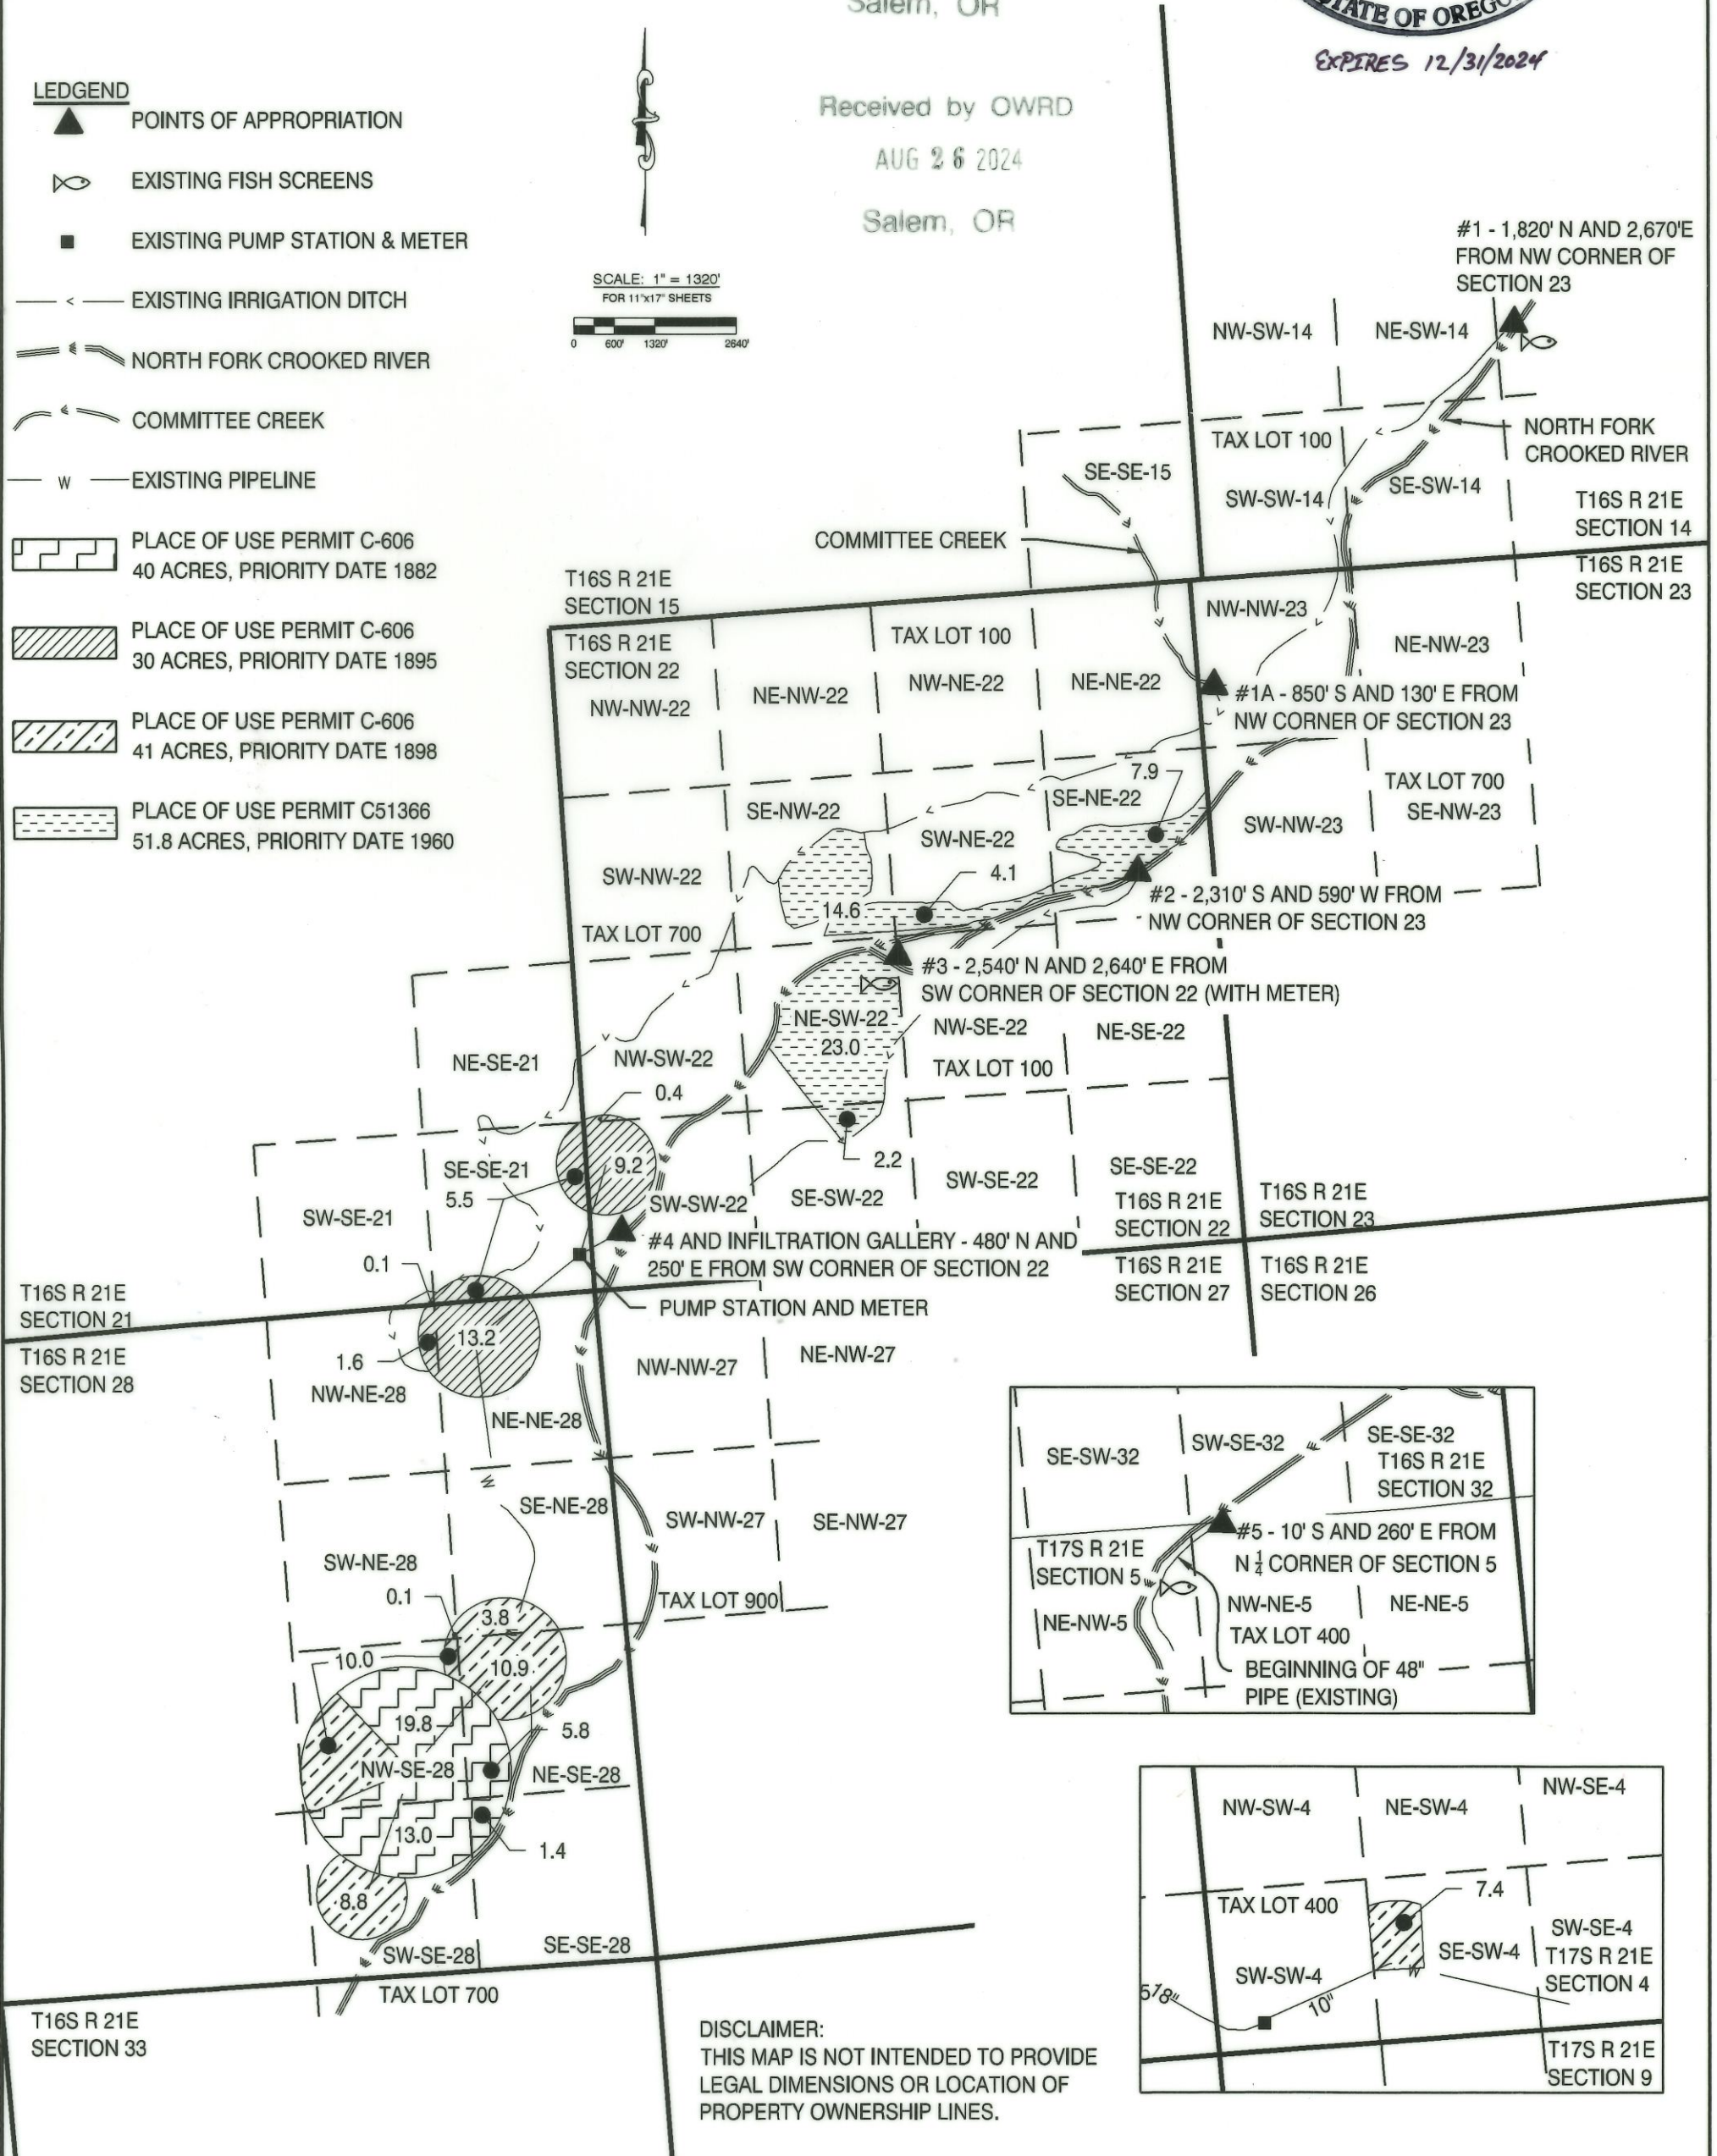

DISCLAIMER:
 THIS MAP IS NOT INTENDED TO PROVIDE LEGAL DIMENSIONS OR LOCATION OF PROPERTY OWNERSHIP LINES.

<p>COBU</p>	<p>JOB NO.: 24-018 DRAWN BY: J.W. DRAWING:</p>	<p>SHEET TITLE: CLAIM OF BENEFICIAL USE MAP</p>	<p>PROJECT: WATER RIGHTS</p> <p>PROJECT LOCATION: CROOK COUNTY, OREGON</p> <p>CLIENT: SOUTH FORK RANCH</p>	<p>H.A. M^cCOY ENGINEERING & SURVEYING, LLC <small>1180 SW Lake Road, Suite 201, Redmond, OR 97756</small> Hayes McCoy PE, PLS, CIVRE 541-923-7554 hayes@ham-engr.com</p>	<table border="1" style="width: 100%; border-collapse: collapse;"> <thead> <tr> <th>DRAWING STATUS:</th> <th>DATE:</th> <th>No.</th> <th>REVISION:</th> <th>DATE:</th> </tr> </thead> <tbody> <tr> <td><input checked="" type="checkbox"/> COBU</td> <td>07/30/24</td> <td>1</td> <td></td> <td></td> </tr> <tr> <td><input type="checkbox"/></td> <td></td> <td></td> <td></td> <td></td> </tr> </tbody> </table>	DRAWING STATUS:	DATE:	No.	REVISION:	DATE:	<input checked="" type="checkbox"/> COBU	07/30/24	1			<input type="checkbox"/>					<input type="checkbox"/>					<input type="checkbox"/>					<input type="checkbox"/>				
DRAWING STATUS:	DATE:	No.	REVISION:	DATE:																															
<input checked="" type="checkbox"/> COBU	07/30/24	1																																	
<input type="checkbox"/>																																			
<input type="checkbox"/>																																			
<input type="checkbox"/>																																			
<input type="checkbox"/>																																			