


# T. 41 S., R. 15 E., W.M.

DIVERSION IS LOCATED  
530 FT. EAST AND  
1230 FT. SOUTH OF THE  
NW COR OF SECTION 7

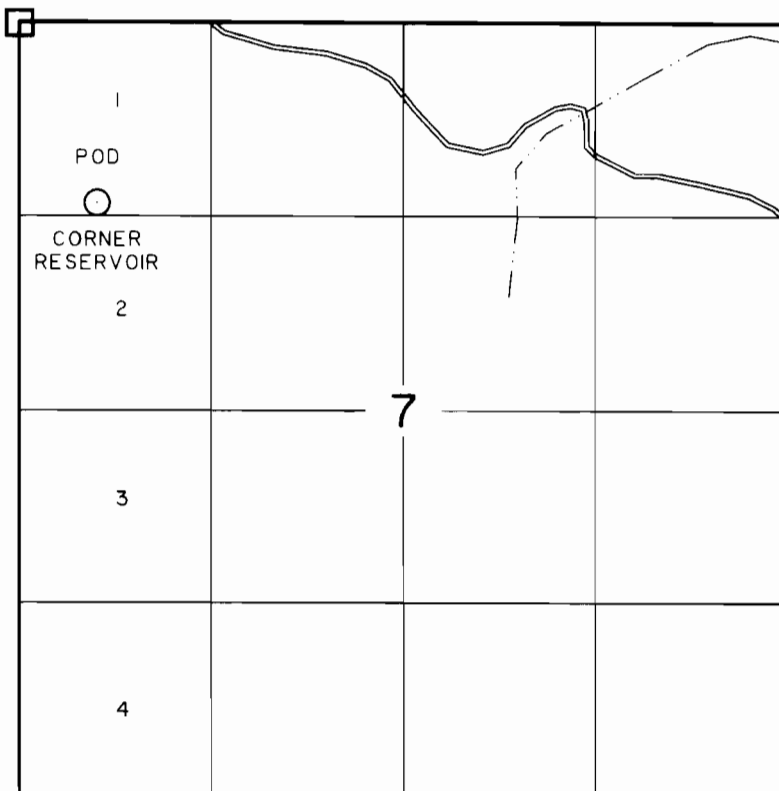

1" = 1320'


## CLAIM OF BENEFICIAL USE MAP

IN NAME OF

### UNITED STATES BUREAU OF LAND MANAGEMENT

APPLICATION NO. R-83418

PERMIT NO. R-12521

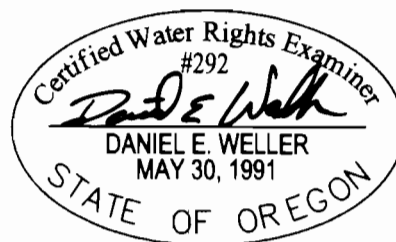

EXPIRES: JUNE 30, 2004

SURVEYED: MAY 7, 2001

THE PURPOSE OF THIS MAP IS FOR IDENTIFYING THE LOCATION OF THE WATER RIGHT ONLY AND IS NOT INTENDED TO PROVIDE LEGAL DIMENSIONS OR LOCATION OF PROPERTY OWNERSHIP LINES.

BLM PROJECT NO. OR-010-R-6527

U.S. BUREAU OF LAND MANAGEMENT-OSO  
BRANCH OF CADASTRAL SURVEY  
DWG: CORNER

EXECUTED BY:  
DANIEL E. WELLER, PLS, CWRE #292  
P.O. BOX 10226  
EUGENE, OREGON 97440