

THIS MAP WAS PREPARED FOR ASSESSMENT PURPOSE ONLY.

SW1/4 SEC.14 T.26S. R.5W. W.M.  
DOUGLAS COUNTY  
1" = 200'

REVISED ON  
8-31-21

26 5 14C


1/4  
COR

SEE MAP 26 5 14A

x = pump  
↑ = house

1070' N & 2000' W  
from 1/4 corner  
sec 14

Tax lot 1100

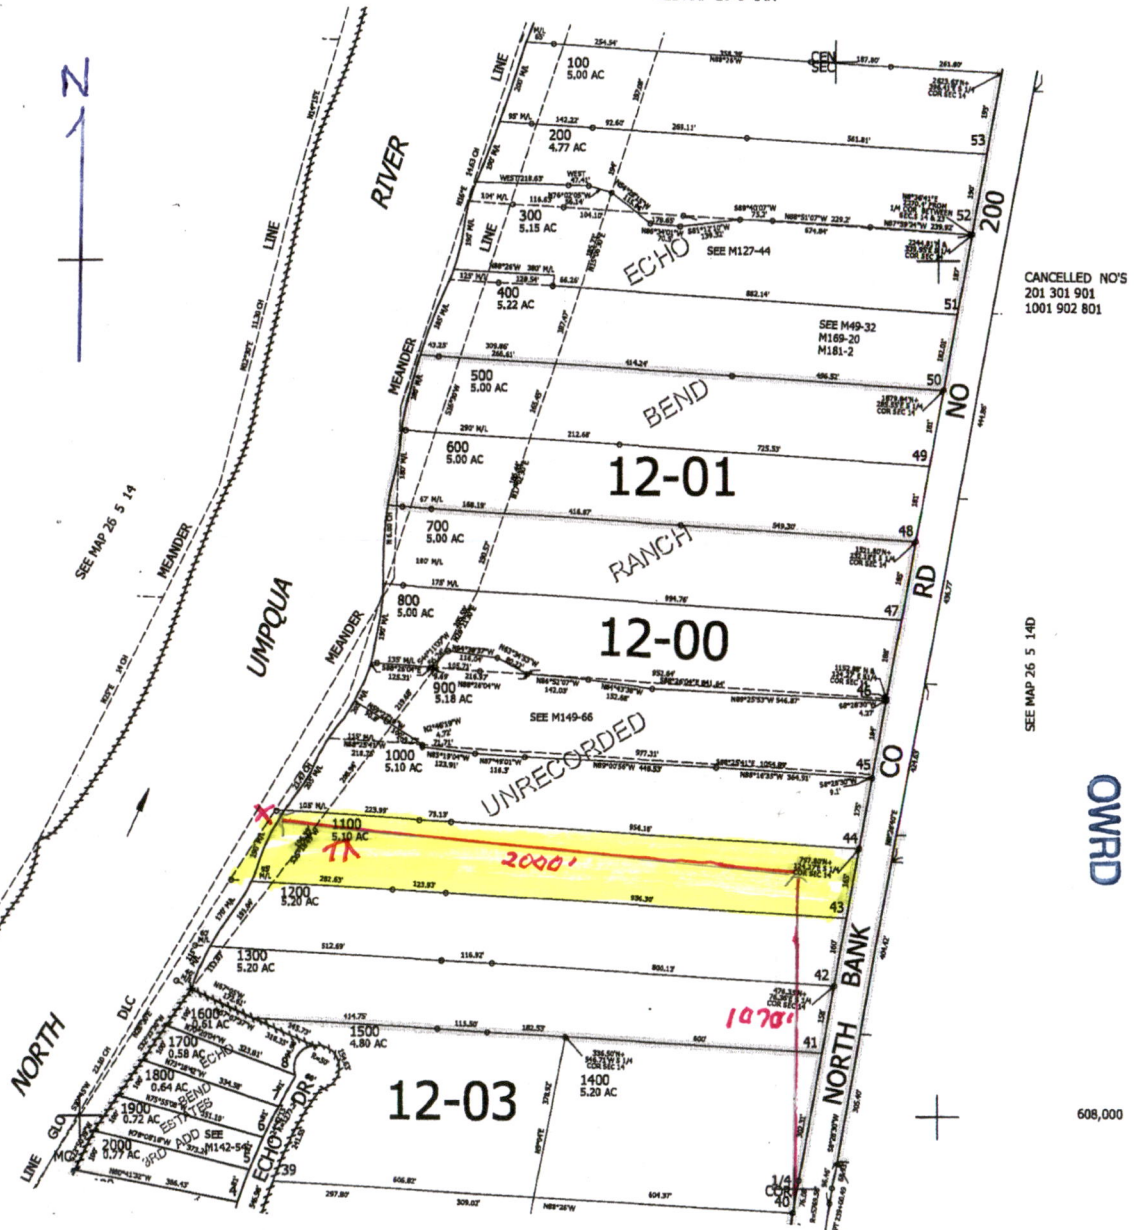

CANCELLED NO'S  
201 301 901  
1001 902 801

SEE MAP 26 5 14D

OWRD

Received  
AUG 26 2024

15 14  
22 23

SEE MAP 26 5 23

000,000 1"

26 5 14C