


RECEIVED

T. 40 S., R. 14 1/2 E., W.M.

MAY - 2 1997

WATER RESOURCES DEPT.
SALEM, OREGON

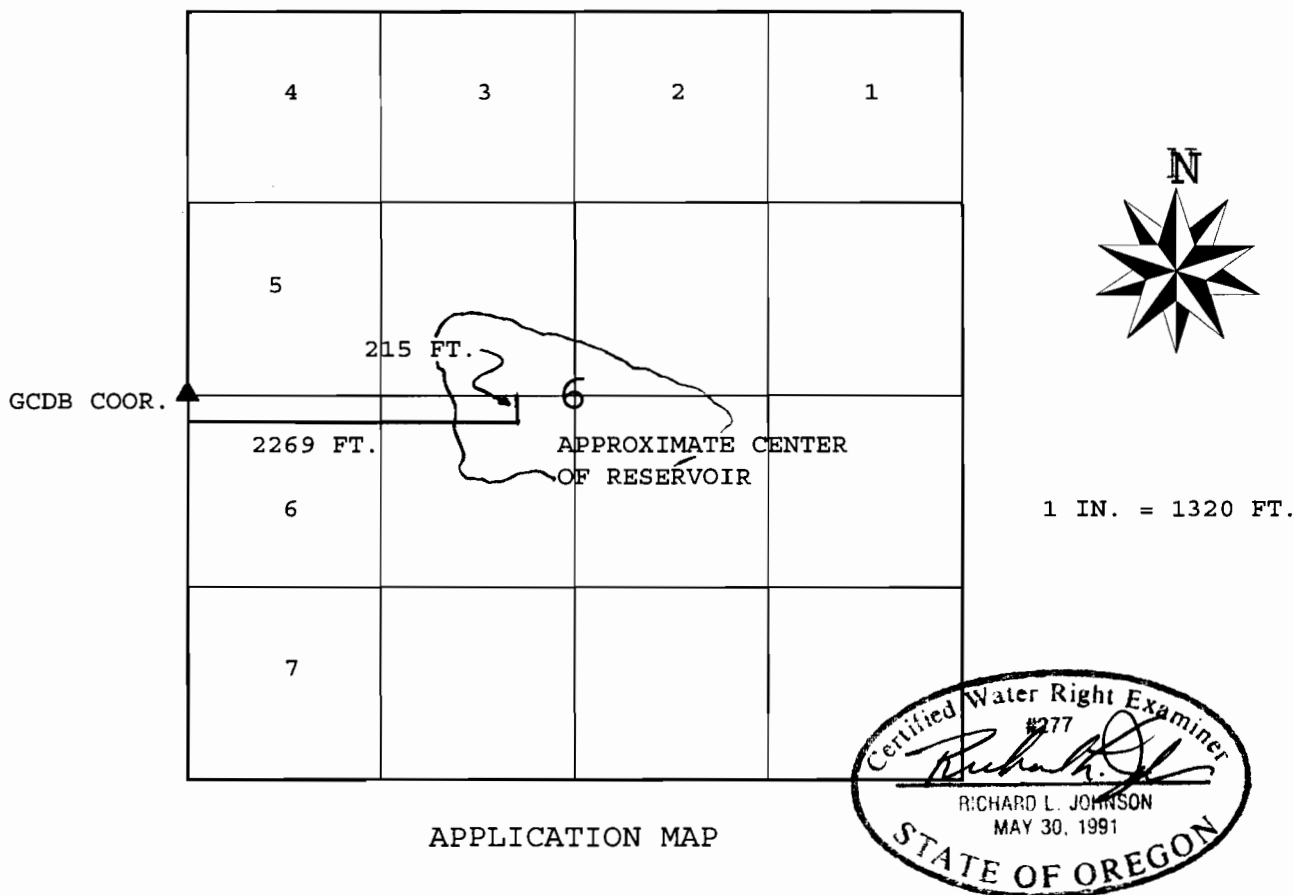

APPLICATION MAP

FOR

UNNAMED RESERVOIR 40S 14 1/2 E

IN NAME OF

UNITED STATES BUREAU OF LAND MANAGEMENT

AUGUST 16, 1995

THE PURPOSE OF THIS MAP IS FOR IDENTIFYING THE LOCATION OF THE WATER RIGHT ONLY AND IS NOT INTENDED TO PROVIDE LEGAL DIMENSIONS OR LOCATION OF PROPERTY OWNERSHIP LINES.

THE TIE WAS DETERMINED FROM AN INVERSE BETWEEN A POSITION, THE CENTER OF THE RESERVOIR, DERIVED FROM A RESOURCE GRADE GLOBAL POSITIONING SYSTEM, A TRIMBLE PATHFINDER, WITH A POSITIONAL ACCURACY OF 2-5 METERS, 50 PERCENT OF THE TIME, AND A POSITION, THE 1/4 SECTION CORNER OF SECTIONS 1 AND 6, DERIVED FROM THE BLM GEOGRAPHIC COORDINATE BASE(GCDB).

WRE-6142A

U.S. BUREAU OF LAND MANAGEMENT - OSO
BRANCH OF CADASTRAL SURVEY

EXECUTED BY:
RICHARD L. JOHNSON, PLS, CWRE

LETTER OF AUTHORIZATION

DATED: JUNE 7, 1995

OR-942.1
P.O. BOX 2965
PORTLAND OR., 97208

R 83425
R-12740