


Claim of Beneficial Use - Green Gold Ag, LLC
 Application S-88692, Permit S-55216

Township 11S, Range 4W, W.M.



POD-R
 1400' N and 2990' W from
 SE corner, section 16
 Flow Meter 20' E of POD
 Fish Screen @ POD

Re- diversion Pt.
 1210' N and 2560' W from
 SE corner, section 16
 Flow Meter 6' S of Re- div. Pt.
 Fish Screen @ Re- div. Pt.

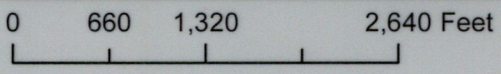

This map is not intended to provide legal dimensions or locations of property ownership lines.

Legend

- POU IR
- Mainline
- Taxlots
- POU IS
- Bulge
- DLC

CERTIFIED WATER RIGHT EXAMINER
30680
William E. McGill
WILLIAM E. MCGILL
MAY 3, 2011
STATE OF OREGON
EXPIRES: 12-31-2024

Received by OWRD
 AUG 28 2024
 Salem, OR