

CLAIM OF BENEFICIAL USE MAP

UNDER APPLICATION R-81941; PERMIT R-12252

NW1/4 NW1/4 SEC 35 T 39S R 44E W.M.


U.S.G.S. QUAD - GRASSHOPPER FLAT SOUTH, OREG. - 7 1/2'



RECEIVED

OCT 8 1981

WATER RESOURCES DIV.


LEGEND

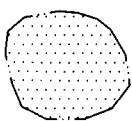-  RESERVOIR
-  SPRING
-  CHANNEL
-  FD SEC COR
-  DRY LAKE BED

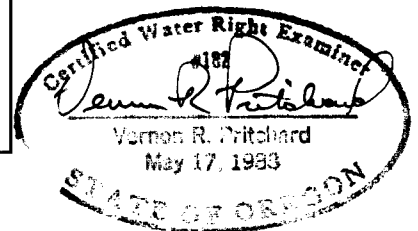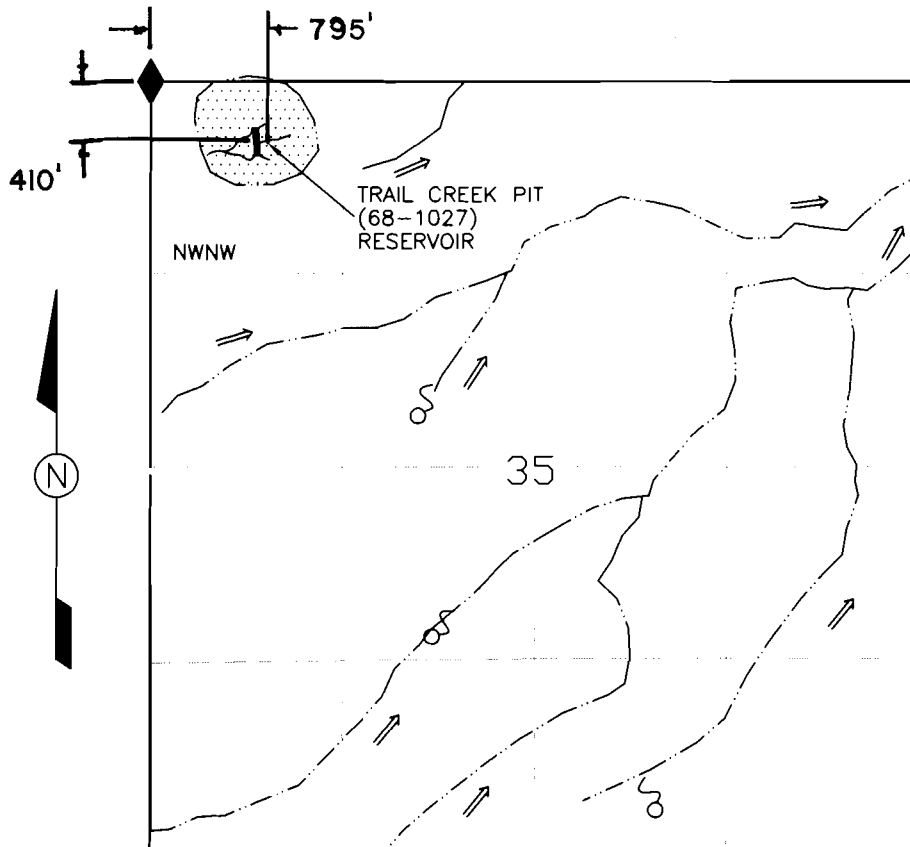

Expires 12/31/02

TRAIL CREEK PIT (68-1027) RESERVOIR

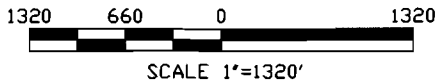

I, Jerry Easton, Acting ADM Operations/Field Services agree to the findings of the CWRE and do submit this site report and map as my Claim of Beneficial Use of the water as provided under the terms and conditions of my Permit R-12252.

Jerry Easton



THIS MAP IS FOR THE PURPOSE OF LOCATING A WATER RIGHT AND IS NOT INTENDED TO PROVIDE LEGAL DIMENSIONS FOR LOCATION OF PROPERTY BOUNDARIES.

ACAD14
DWG FILE: TRAILCRBEN

UNITED STATES DEPARTMENT OF THE INTERIOR
BUREAU OF LAND MANAGEMENT
DIVISION OF OPERATIONS VALE DISTRICT

TRAIL CREEK PIT (68-1027) RESERVOIR

DRAWN BY:	<u>Jerry Easton</u>
SURVEYED:	<u>Vernon R. Ditchard</u>
APPROVED:	<u>Jerry Easton</u> ADM/OPERATIONS AND FIELD SERVICES
DRAWN:	CG
DATE:	10/18/00
DRAWING NO.	OR-03-9172.45-1063
SCALE:	1"=1320'
SHEET	1 OF 1