
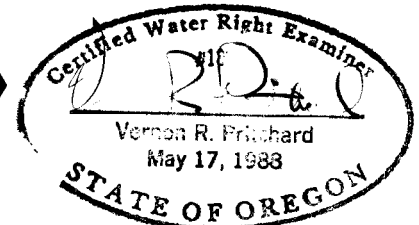


CLAIM OF BENEFICIAL USE MAP

UNDER APPLICATION R-81940; PERMIT R-12251

SW1/4 SE1/4 SEC 32 T 33S R 41E W.M.

U.S.G.S QUAD - THE BASIN, OREG. - 7 1/2'

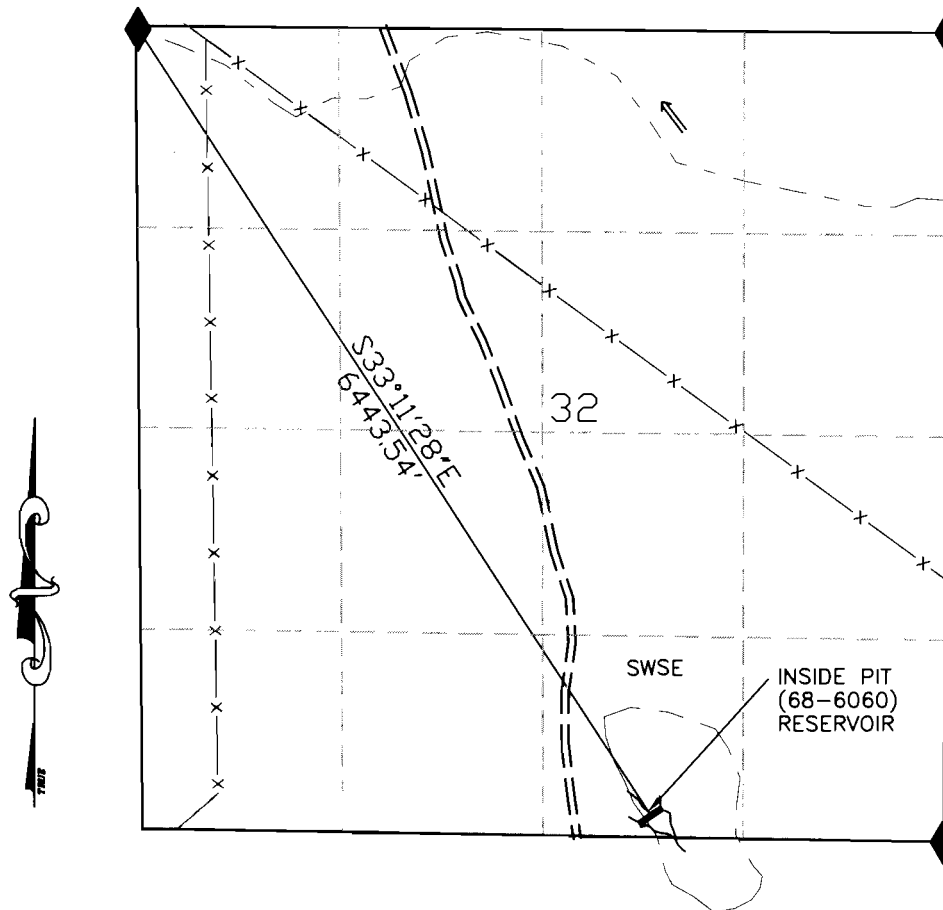

Expires 12/31/02

LEGEND



RESERVOIR



ROAD



CHANNEL



FD SEC COR



FENCE




DRY LAKE BED

INSIDE PIT (68-6060) RESERVOIR

RECEIVED

OCT 01 2001

WATER RIGHTS DIV.

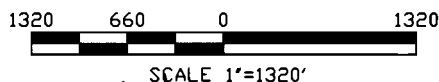

I, Jimmy Estro, Acting ADM Operations/Field Services agree to the findings of the CWRE and do submit this site report and map as my Claim of Beneficial Use of the water as provided under the terms and conditions of my Permit R-12251.

Jimmy Estro

THIS MAP IS FOR THE PURPOSE OF LOCATING A WATER RIGHT AND IS NOT INTENDED TO PROVIDE LEGAL DIMENSIONS FOR LOCATION OF PROPERTY BOUNDARIES.



ACAD14/SDSK8.0
DWG FILE: INSIDEBEN.DWG

UNITED STATES DEPARTMENT OF THE INTERIOR
BUREAU OF LAND MANAGEMENT
DIVISION OF OPERATIONS VALE DISTRICT

INSIDE PIT (68-6060) RESERVOIR

DRAWN BY: Jimmy Estro
SURVEYED: Vernon R. Pritchard
APPROVED: Jimmy Estro
ADM OPERATIONS AND FIELD SERVICES

DRAWN: CG SCALE: 1"=1320'
DATE: 10/18/00 SHEET 1 OF 1
DRAWING NO. OR-03-9172.45-1056