

# T16S R4W, WM LANE COUNTY, OR




0 400 Feet


1" = 400'

- Well & Meter
- Pipeline
- - - - - DLC
- Section
- Quarter Quarter
- Tax Lot
- ▨ POU IR

Well (LANE 8066) Location:  
80' N, 1120' W of SW Cor DLC 48

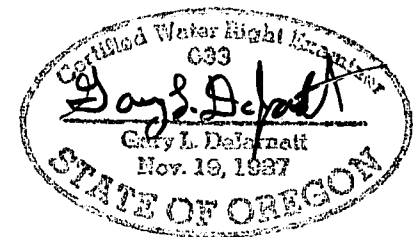

RENEWAL DATE 12/31/2025

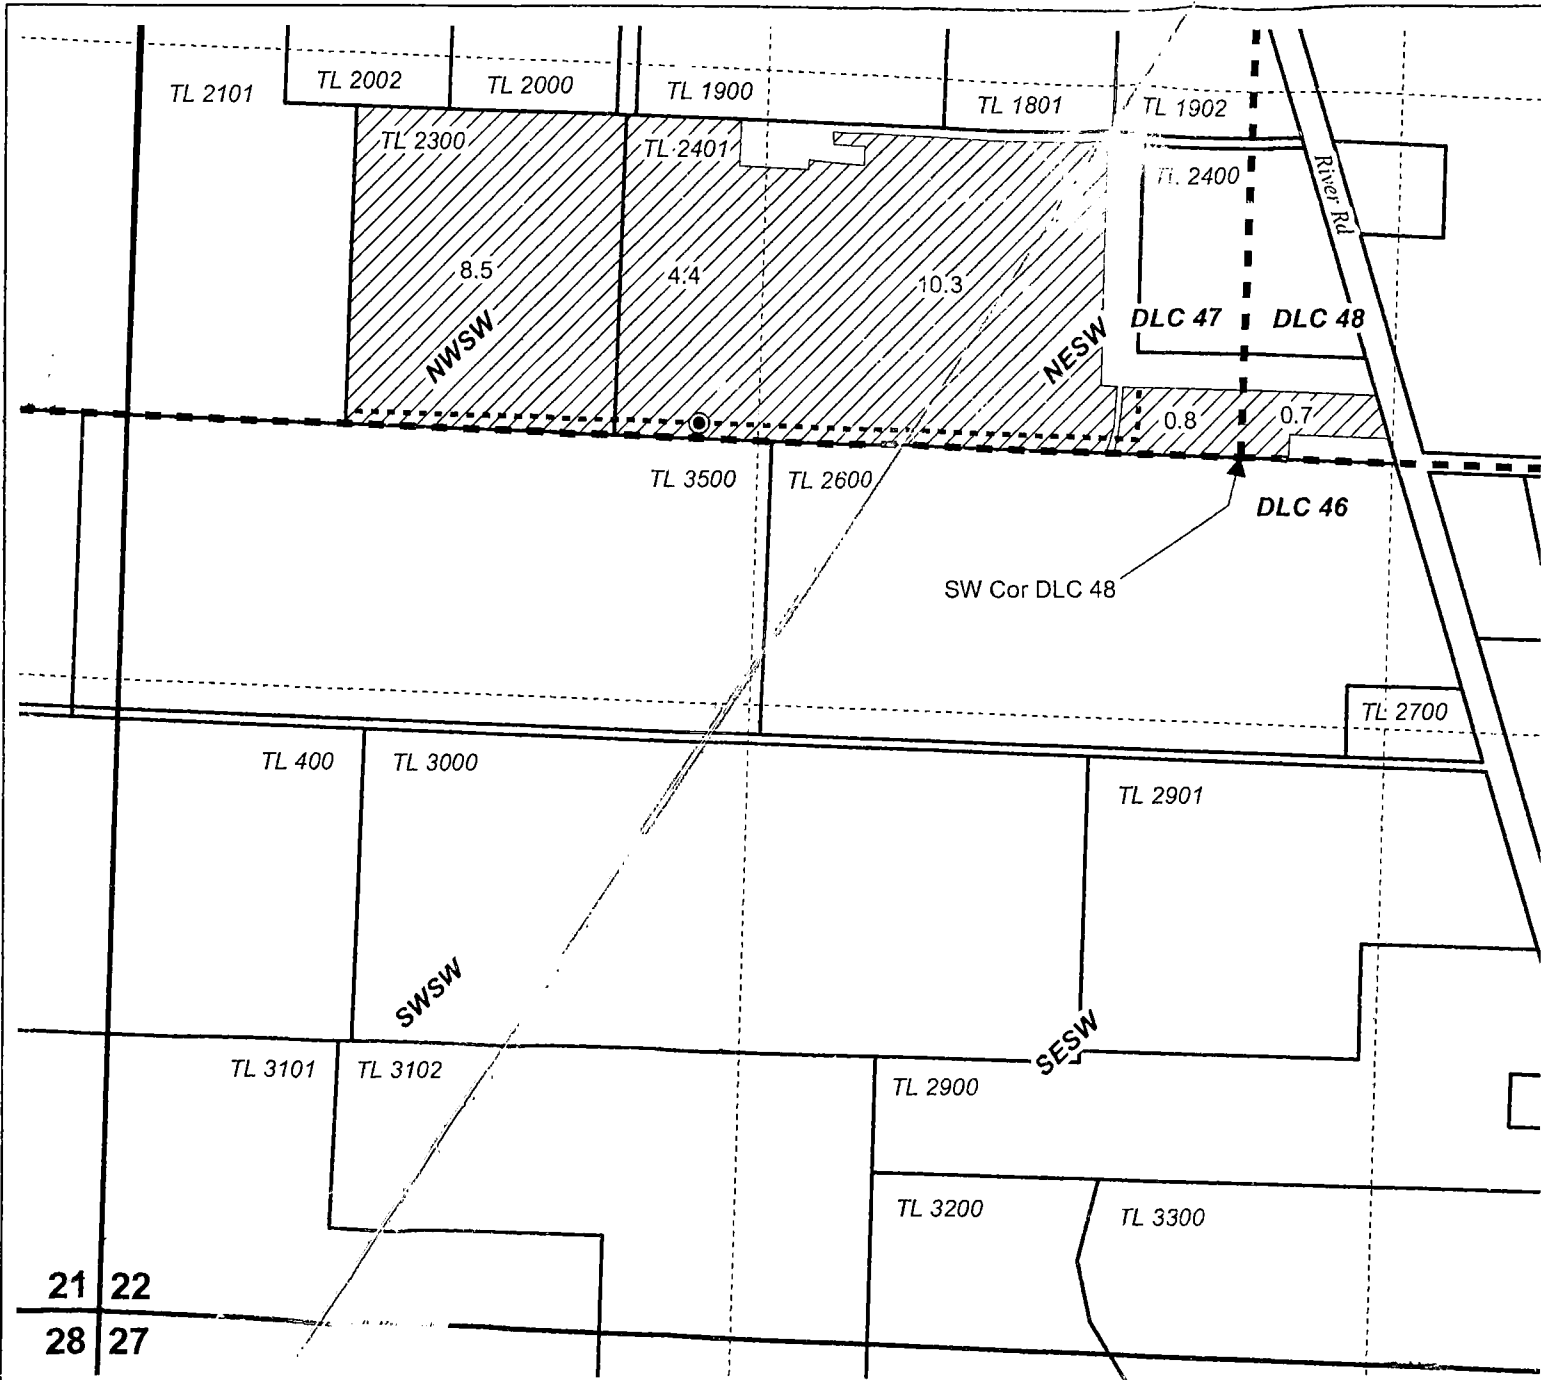

## CLAIM OF BENEFICIAL USE MAP RUSSELL

Date: 7/5/2024

Ap G-17453 Permit G-16892 #24013

This map is not intended to provide legal dimensions or locations of property ownership lines.

**WATER RIGHT SERVICES, LLC**  
PO BOX 1830, BEND, OR 97709  
**WWW.OREGONWATER.RS CCB # 197121**  
johnshort@usa.com 541-389-2837