


CLAIM OF BENEFICIAL USE MAP

UNDER APPLICATION R-81929; PERMIT R-12299


NE1/4NE1/4 SEC 27 T 7S R 41E W.M.

U.S.G.S. QUAD - KEATING NW, OREG. - 7 1/2'

RECEIVED
OCT 8 1 2001
WATER RESOURCES DIV.

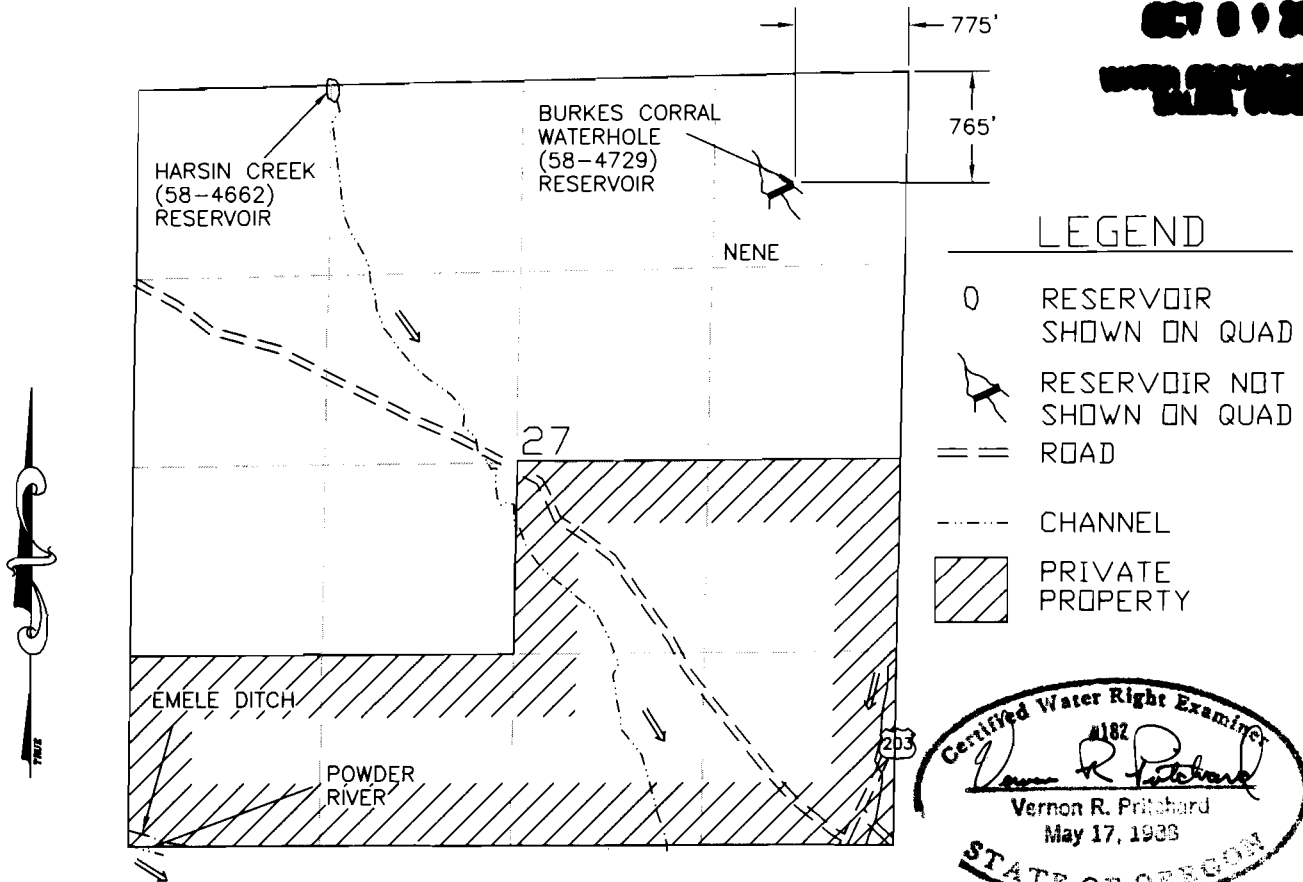

BURKES CORRAL WATERHOLE (58-4729) RESERVOIR

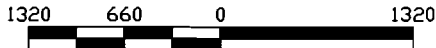

SCALE 1"=1320'

I, Jerry Costello, Acting ADM Operations/Field Services agree to the findings of the CWRE and do submit this site report and map as my Claim of Beneficial Use of the water as provided under the terms and conditions of my Permit R-12299.

THIS MAP IS FOR THE PURPOSE OF LOCATING A WATER RIGHT AND IS NOT INTENDED TO PROVIDE LEGAL DIMENSIONS FOR LOCATION OF PROPERTY BOUNDARIES.

ACAD2000
DWG FILE: BURKECBEN.DWG

ALWAYS
THINK
SAFETY

UNITED STATES DEPARTMENT OF THE INTERIOR
BUREAU OF LAND MANAGEMENT
DIVISION OF OPERATIONS VALE DISTRICT

BURKES CORRAL WATERHOLE
(58-4729) RESERVOIR

DRAWN BY: Vernon R. Pritchard
SURVEYED: Vernon R. Pritchard
APPROVED: Jerry Costello
ADM OPERATIONS AND FIELD SERVICES

DRAWN: CG SCALE: 1"=1320'
DATE: 08/22/01 SHEET 1 OF 1
DRAWING NO. OR-03-9172.45-00