


CLAIM OF BENEFICIAL USE MAP

UNDER APPLICATION R-81925; PERMIT R-12295

SE1/4 NW1/4 SEC 31 T 7S R 42E W.M.

U.S.G.S. QUAD SAWTOOTH RIDGE, OREG. - 7 1/2'

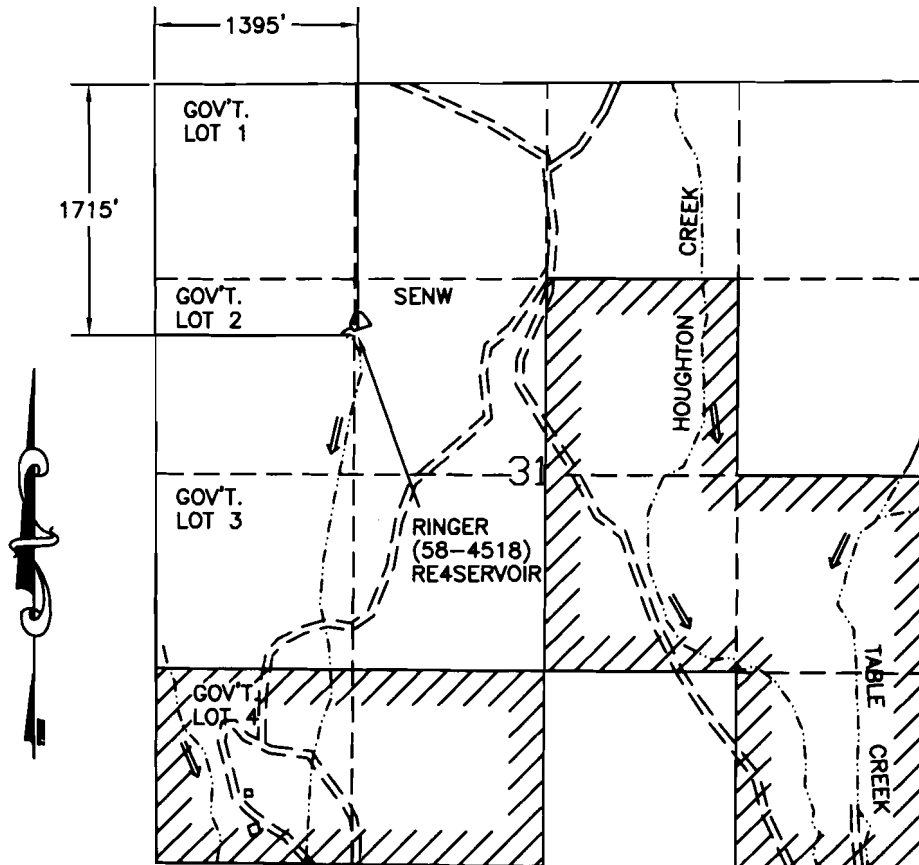

LEGEND

▷ RESERVOIR


== ROAD

--- CHANNEL

PRIVATE PROPERTY

RECEIVED

MAY 26 2002
WATER RESOURCES DEPT
SALEM, OREGON

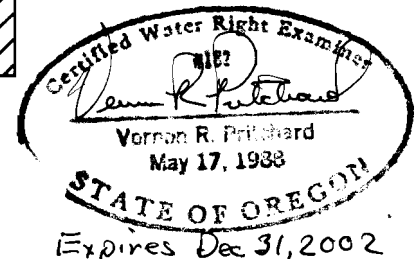

RINGER (58-4518) RESERVOIR

1320 660 0 1320
SCALE 1"=1320'

I, Thomas Terry, ADM Operations/Field Services agree to the findings of the CWRE and do submit this site report and map as my Claim of Beneficial Use of the water as provided under the terms and conditions of my Permit R-12295



THIS MAP IS FOR THE PURPOSE OF LOCATING A WATER RIGHT AND IS NOT INTENDED TO PROVIDE LEGAL DIMENSIONS FOR LOCATION OF PROPERTY BOUNDARIES.

ACAD2000/LDD
DWG FILE: RINGERBEN

UNITED STATES DEPARTMENT OF THE INTERIOR BUREAU OF LAND MANAGEMENT DIVISION OF OPERATIONS VALE DISTRICT	
RINGER (58-4518) RESERVOIR	
DRAWN BY: <i>Vernon R. Pritchard</i>	
SURVEYED BY: <i>Vernon R. Pritchard</i>	
APPROVED BY: <i>Thomas Terry</i> ADM OPERATIONS AND FIELD SERVICES	
DRAWN: CG	SCALE: 1"=1320'
DATE: 11/01/01	SHEET 1 OF 1
DRAWING NO. DR-03-9172.45-1060	