
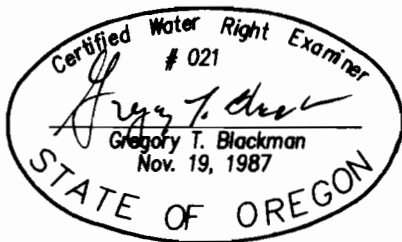


RECEIVED

JAN 26 2001

WATER RESOURCES DEPT  
SALEM, OREGON

TOWNSHIP 2 SOUTH RANGE 44 EAST

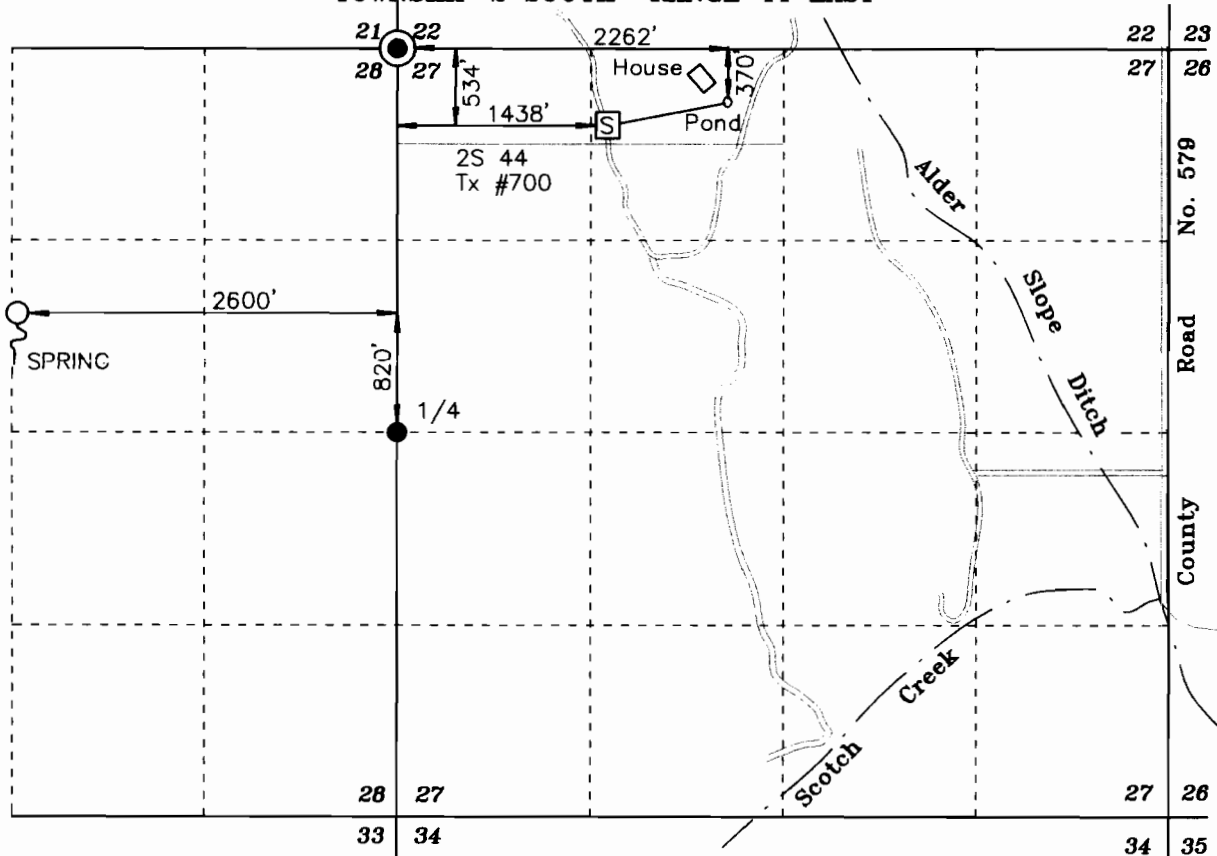

**FINAL PROOF MAP OF  
STORAGE POND**

FOR

**George S. Gabriel**

BY

**BAGETT- GRIFFITH & BLACKMAN**

**2006 ADAMS AVE.**

**LAGRANDE, ORE. 97850**

**December 22, 2000**

NOTE: The preparation of this map was for the purpose of identifying the location of the proposed water right and has no intent to provide dimensions or location of property ownership lines. Location information shown hereon was furnished by the applicant.

APPLICATION NO. **R- 83531**

PERMIT NO. **R- 12918**