



TOWNSHIP 14 SOUTH, RANGE 12 EAST, W.M.

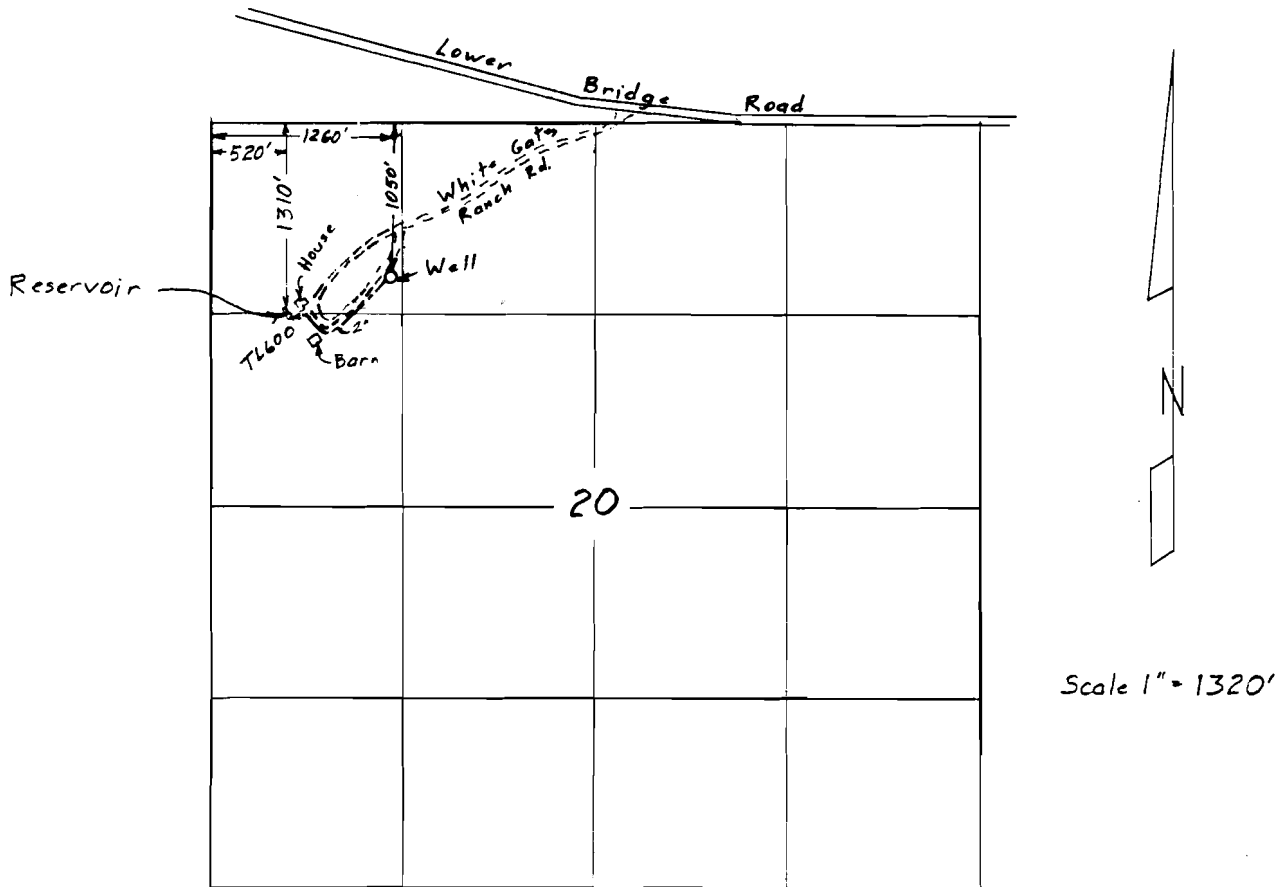

Surveyed March 10, 2000

Claim of Beneficial Use  
for  
EUGENE & JOYCE FALTUS

Application R-81330  
Permit R-12132

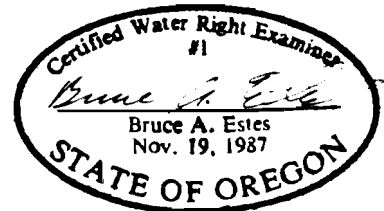

This map is for the purpose of  
locating a water right only  
and has no intent to provide  
legal dimensions or the location  
of property lines.

**ESTES SURVEYS**  
PO Box 17519      60382 Arnold Rd  
Salem, OR 97305-7519      Bend, OR 97702  
(503) 585-7593      (541) 382-7391