


# T.36S.,R.1W.,W.M.

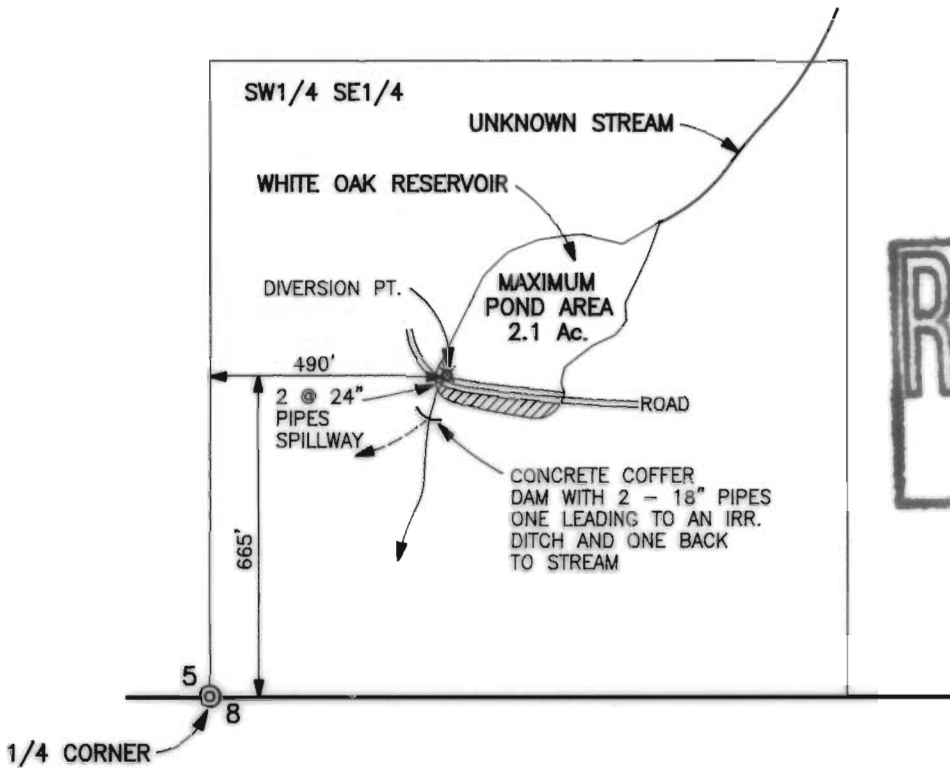

SCALE 1" = 400'



FINAL PROOF MAP

APPLICATION No. R-77839  
PERMIT No. R-12144

IN THE NAME OF  
WHITE OAK RANCH

NOTE: MAP PREPARED FOR  
WATER RIGHT PURPOSES ONLY,  
NOT FOR PROPERTY BOUNDARY  
LOCATIONS.

MAP PREPARED APRIL 19, 2000 BY GARY D. KAISER

