


RECEIVED

AUG 21 1996

WATER RESOURCES DEPT.
SALEM, OREGON

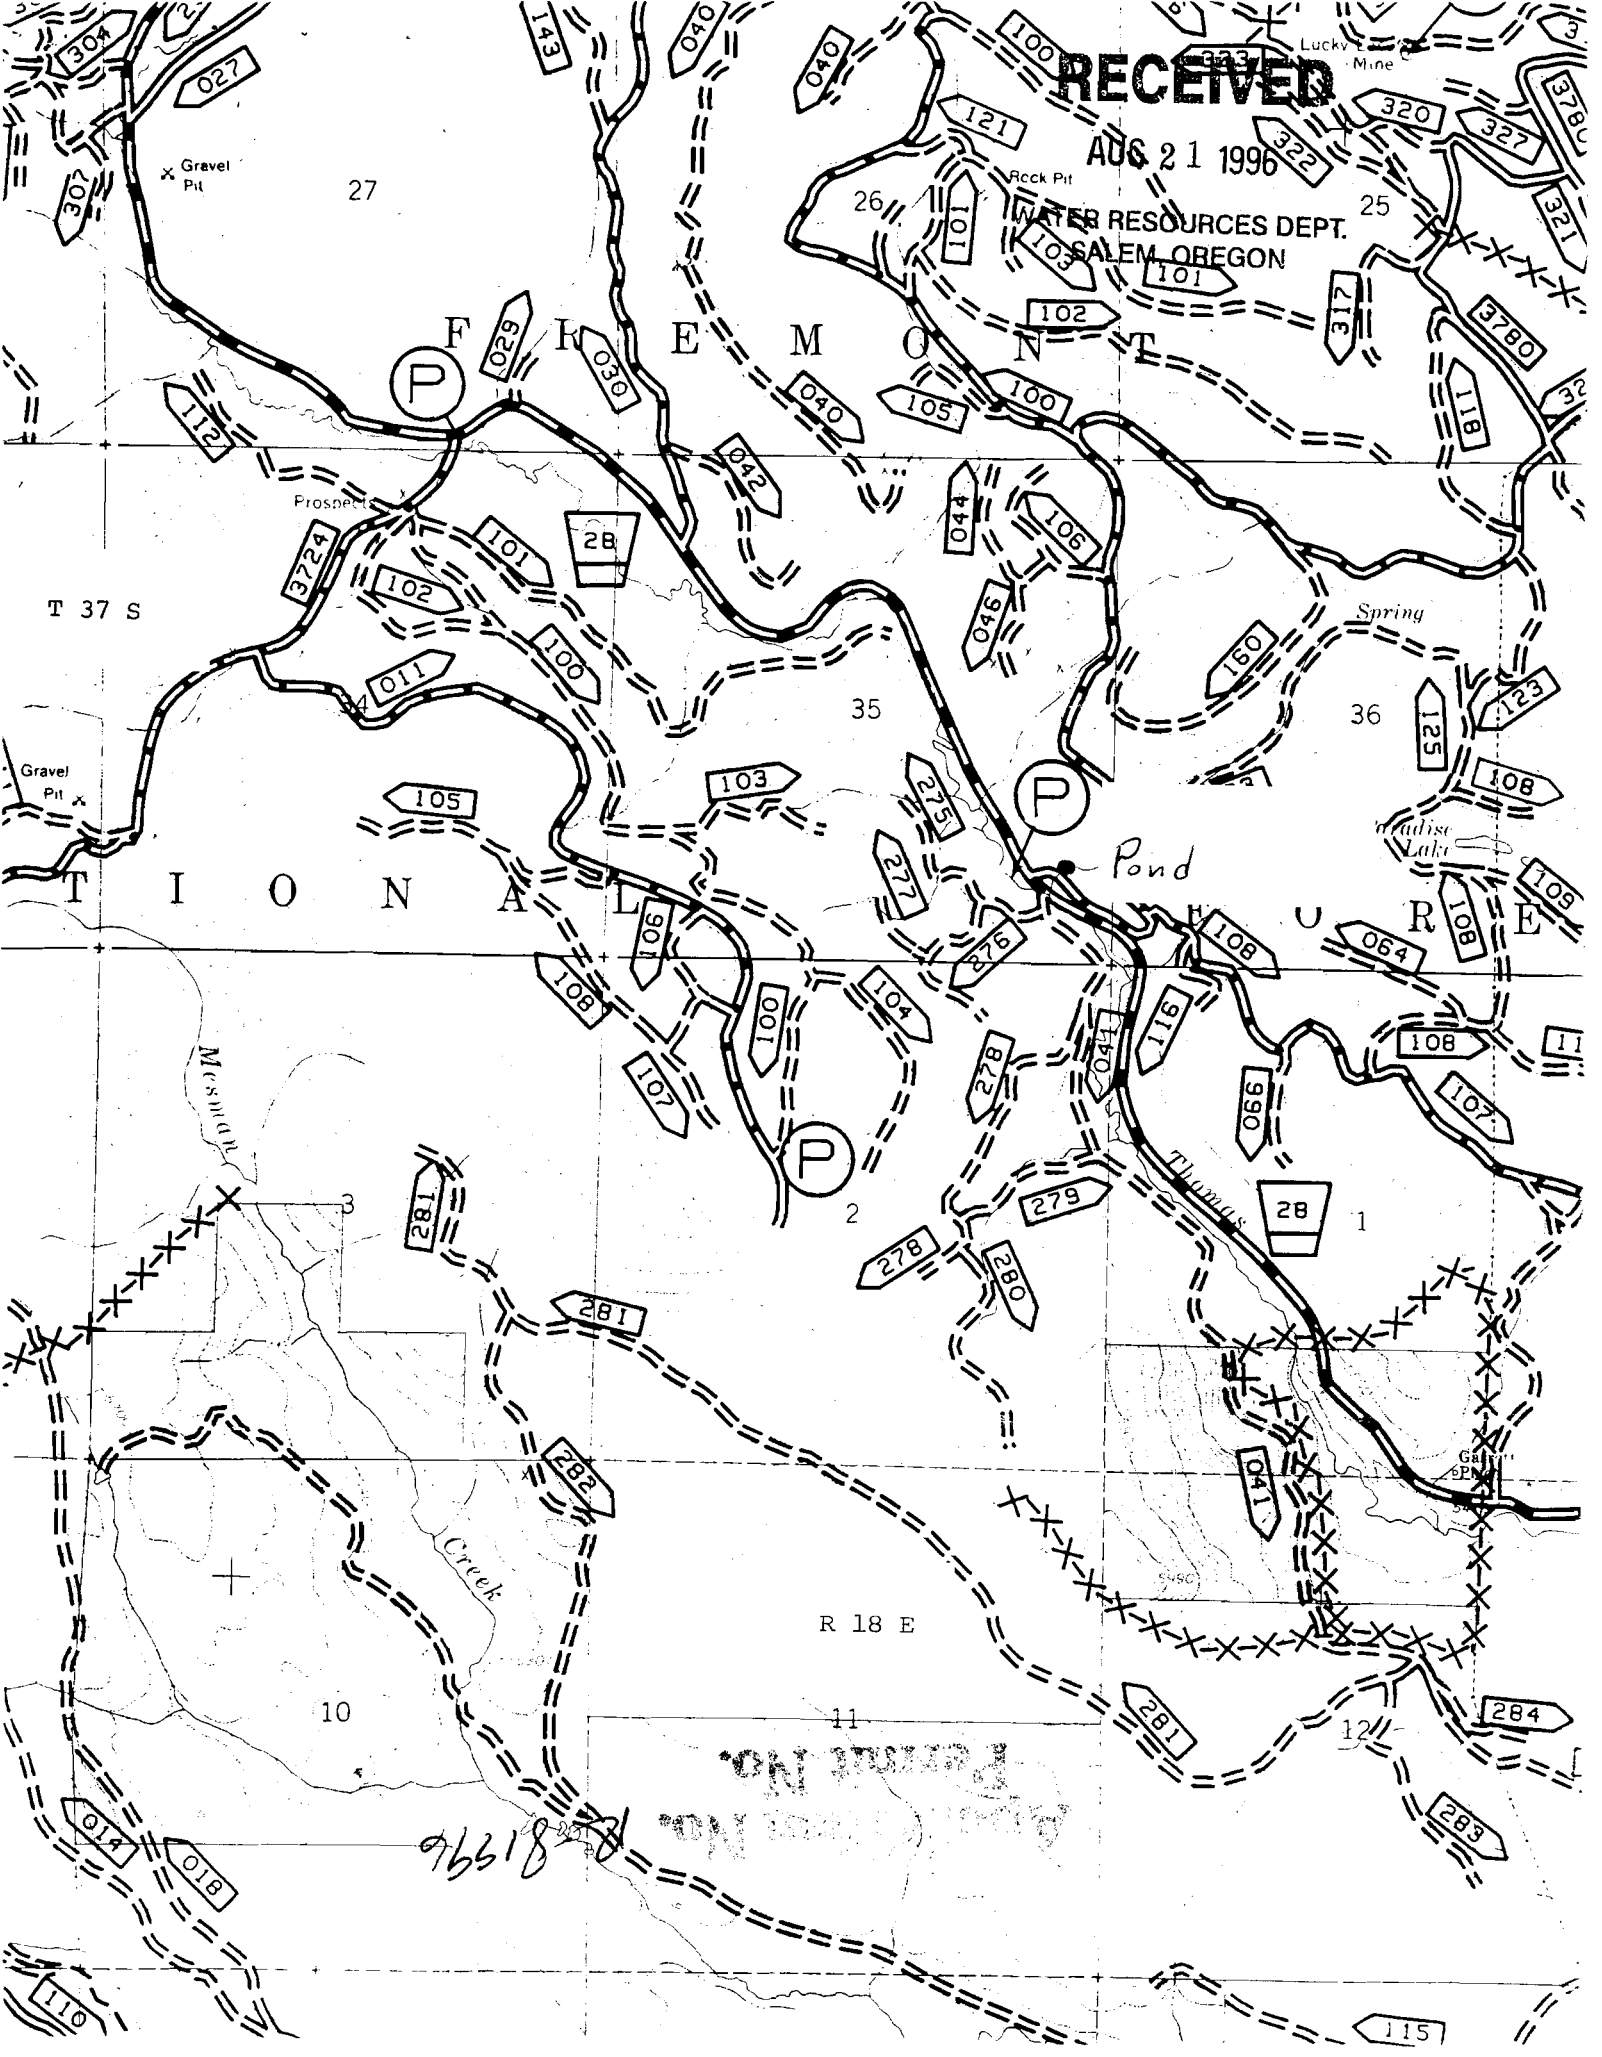

96318
81996

