


DC/WKD

CLAIM OF BENEFICIAL USE SURVEY G177668
T39S R7W S28 W.M. - ROGUE RIVER BASIN - JOSEPHINE COUNTY OREGON

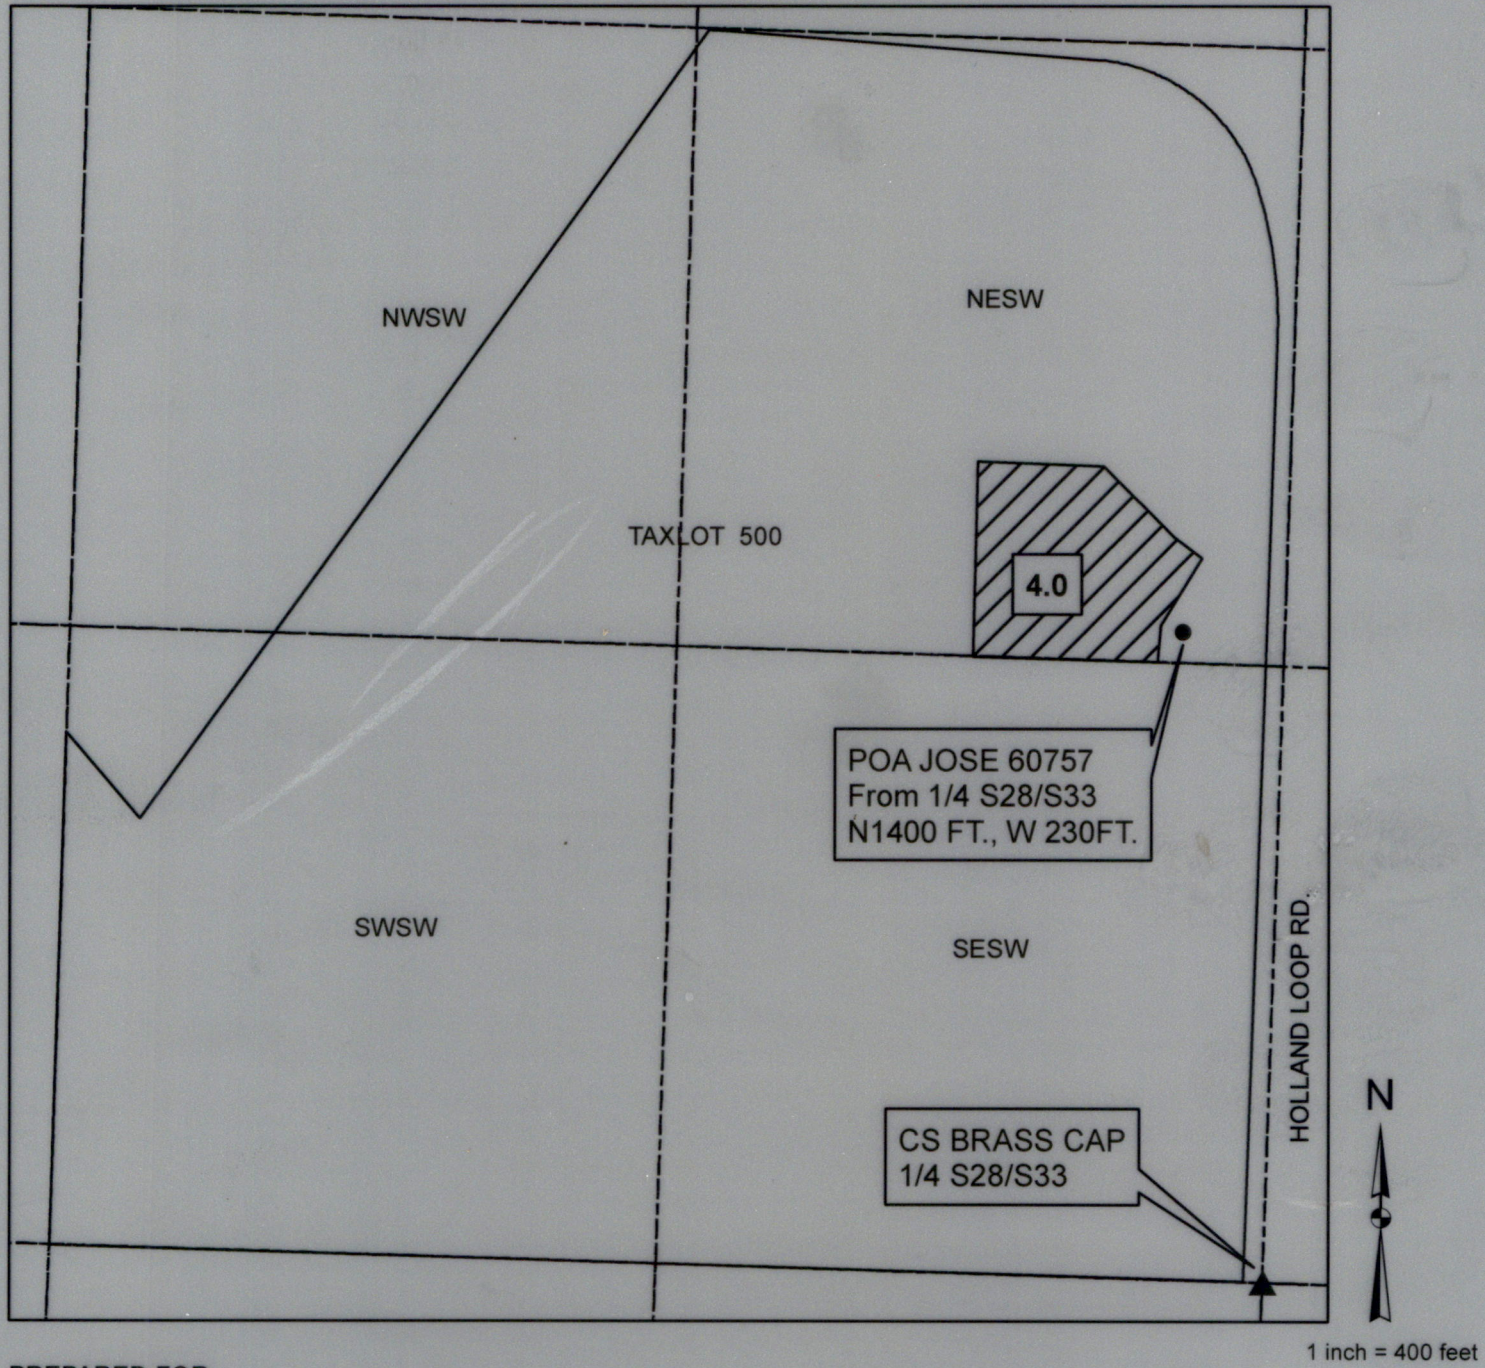

PREPARED FOR:
Greg Brooks
5353 Dick George Rd.
Cave Junction, OR
97523

PREPARED BY:
Scott Fein, CWRE
600 Tyler Creek Rd.
Ashland, OR 97520
sfeinsurveyor@gmail.com
541-842-0795

FOR WATER RIGHTS PURPOSES ONLY
NOT FOR PROPERTY BOUNDARY LOCATIONS
OR DIMENSIONS.

Received
SEP 03 2024
OWRD

CERTIFIED WATER RIGHT EXAMINER
83181
Scott D. Fein
SCOTT D. FEIN
MAY 10, 2012
STATE OF OREGON
RENEWED 12/31/2023
Renew 12/31/25