T.6S. R.3W. Sec. 23 & 24, W.M.

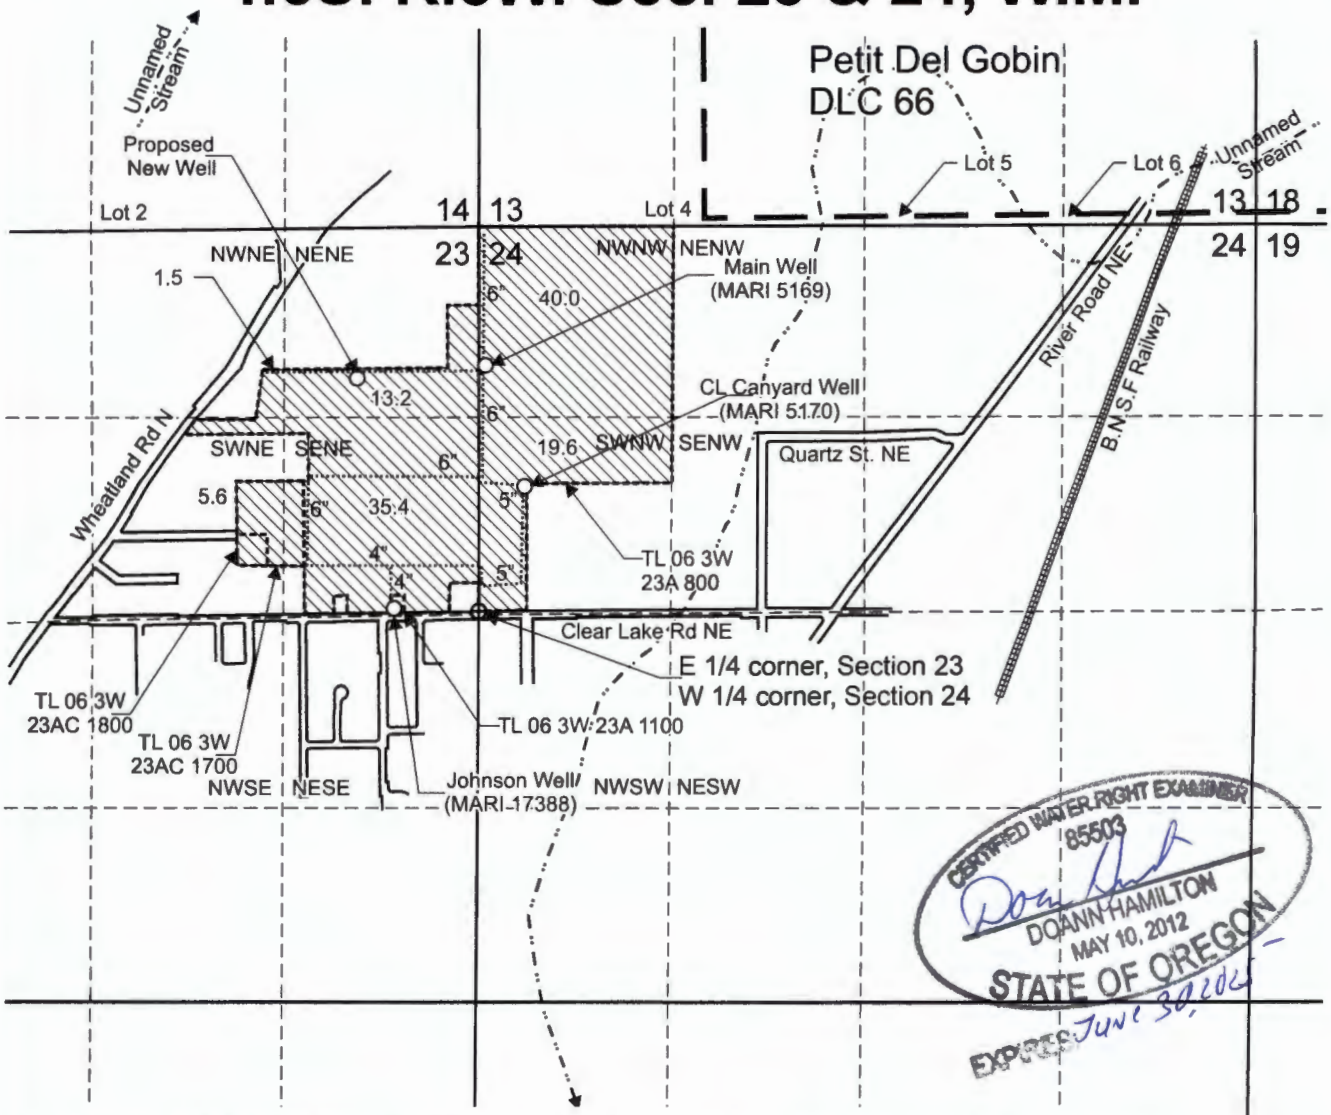

CL Canyard Well (MARI 5170) is located 870 feet north and 310 feet east from the W 1/4 corner, Section 24.

Main Well (MARI 5169) is located 1,680 feet north and 40 feet east from the W 1/4 corner, Section 24.

Proposed New Well is located 1,040 feet south and 825 feet west from the NE corner, Section 23.

Johnson Well (MARI 17388) is located 40 feet north and 580 feet west from the E 1/4 corner, Section 23.

Area (115.3 Acres) to be covered under nursery operations.

Tax lot boundary

Donation Land Claim boundary

Water main line

Received
SEP 03 2024
OWRD

N

Scale: 1" = 1,320'

0 1,320 Feet

This map was prepared for the purpose of identifying the location of a water right only and is not intended to provide legal dimensions or location of property ownership lines.

Water Right Application Map

Pacific Hydro-Geology Inc.

Clearlake Farms LLC
T.6S. R.3W. Sec. 23 & 24, W.M.

08/2024

GabrielCLNurseryGWAppMap.cdr