

Received by OWRD

SEP 00 2024

SALEM, OR


Section 14, T23S, R6E, W.M.,
Klamath County, Oregon

RECEIVED BY OWRD


SEP 04 2024

SALEM, OR

Application S-87362, Permit S-54678
CLAIM OF BENEFICIAL USE MAP
Nancy and Pat Cross

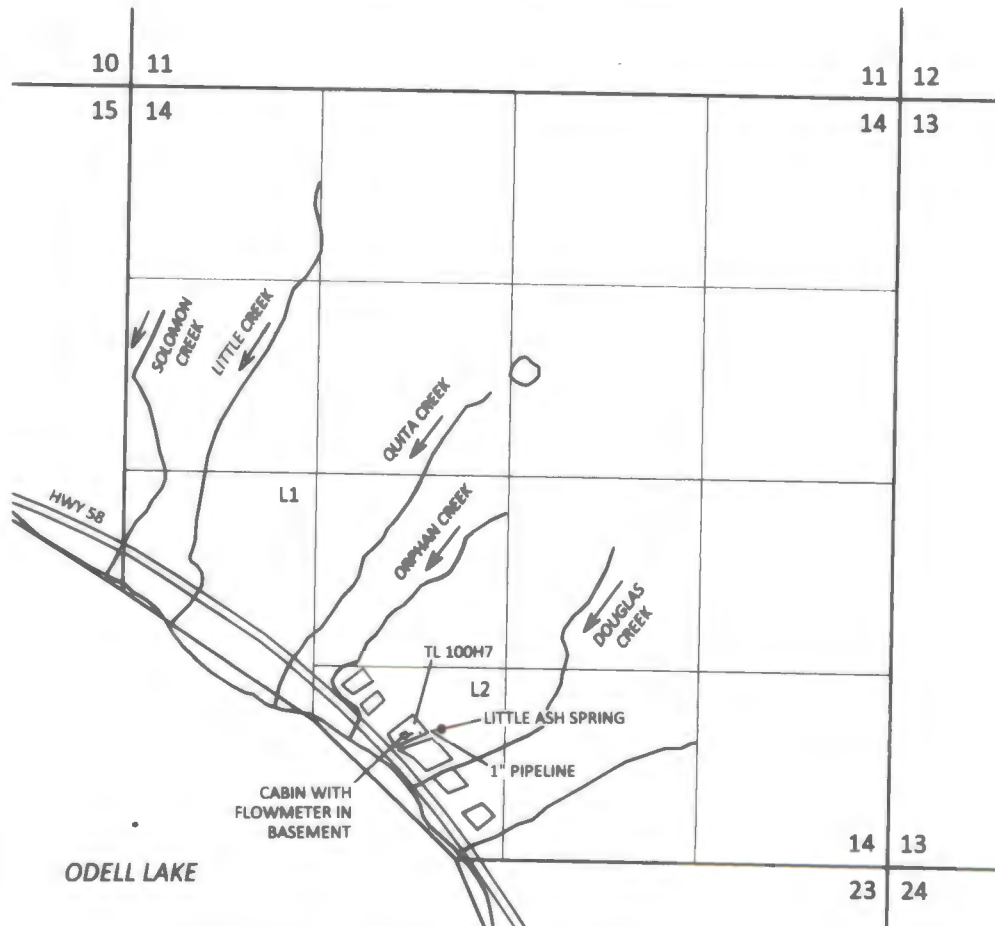

POD LOCATION: 910 FT N AND 420 FT W FROM
SOUTH 1/4 CORNER SECTION 14, T23S, R6E, W.M.

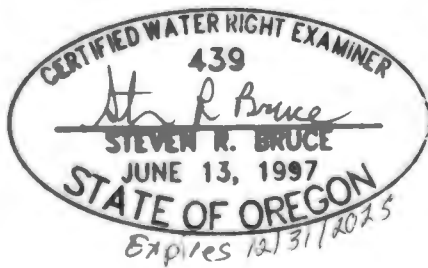

EXPLANATION

- PLACE OF USE - HUMAN CONSUMPTION
PRIORITY: 12/12/2008
- SPRING
- APPROXIMATE PIPELINE



KPFF 2200002.25

SKOOKUM
WATER ASSOCIATES INC

1626 VICTORIAN WAY
EUGENE, OR 97401
(503) 319-8926

Site Inspection Conducted
July 24, 2024

August 26, 2024

This map is not intended to provide legal
dimensions or locations of property
ownership lines

Figure 1