


SECTION 28 T.4S. R.1E. W.M.
CLACKAMAS COUNTY
1" = 400'

D.L.C.
ANDREW E. GRIBBLE NO. 41
ISAAC WHEALDON NO. 43
JAMES SHIRLEY NO. 45

Cancelled Taxlots

- 1790
- 1798
- 711
- 762
- 1558
- 728
- 156
- 1888
- 182
- 190
- 288
- 781
- 713C1
- 713C2
- 714C1
- 714C2
- 717C1
- 717C2
- 718C1
- 718C2
- 756
- 786C2
- 791
- 782
- 783C1
- 783C2
- 784
- 785C1
- 785C2
- 786
- 891
- 892
- 893
- 986
- 1182
- 1090
- 1890
- 1980

- Parcel Boundary
- Private Road ROW
- Historical Boundary
- Railroad Centerline
- Tax Code Lines
- Map Index
- Water Lines
- Land Use Zoning
- Flats
- Water
- Corner
- Section Corner
- 1/16th Line
- Govt Lot Line
- DLC Line
- Meander Line
- PLS Section Line
- Historic Corridor 40'
- Historic Corridor 20'

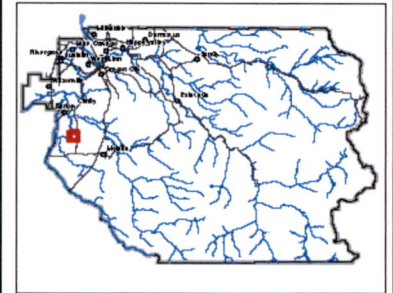

Well CLAG 12603
10 3/4 chains South and 1/2 chain West
from NW corner of Whealdon DLC 43

THIS MAP IS FOR ASSESSMENT
PURPOSES ONLY

