

FINAL PROOF SURVEY MAP IN THE NAME OF SHANE KENT

APPLICATION S - 81959
APPLICATION R - 81960

PERMIT 53419
PERMIT R-12494


SECTION 10, TOWNSHIP 31 SOUTH, RANGE 15 WEST, W.M.



RECEIVED

NOV 07 2003

WATER RESOURCES DEPT
SALEM, OREGON

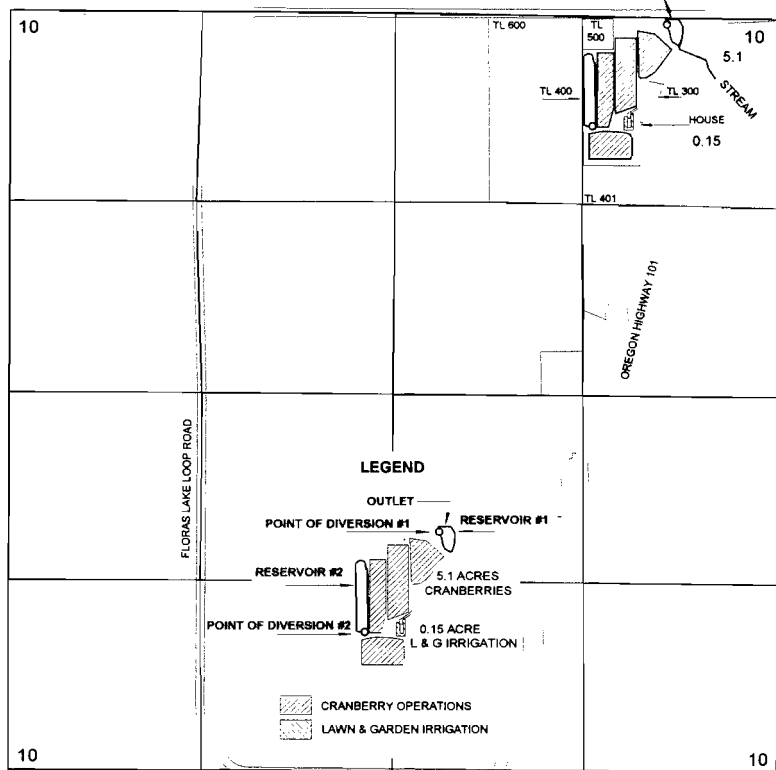

THE POINTS OF DIVERSION ARE LOCATED AS FOLLOWS:

- No. 1: 80 FEET SOUTH AND 1840 FEET EAST;
- No. 2: 780 FEET SOUTH AND 1335 FEET EAST; BOTH

FROM THE NORTH QUARTER CORNER OF SECTION 10; BEING WITHIN THE NE $\frac{1}{4}$ NE $\frac{1}{4}$ OF SECTION 10, TOWNSHIP 31 SOUTH, RANGE 15 WEST, W.M.; CURRY COUNTY.

THE RESERVOIRS ARE LOCATED AS FOLLOWS:

- No. 1: 40 FEET SOUTH AND 1890 FEET EAST (OUTLET IN COUNTY ROAD);
- No. 2: 520 FEET SOUTH AND 1320 FEET EAST (CENTER OF RESERVOIR); BOTH

FROM THE NORTH QUARTER CORNER OF SECTION 10; BEING WITHIN THE NE $\frac{1}{4}$ NE $\frac{1}{4}$ OF SECTION 10, TOWNSHIP 31 SOUTH, RANGE 15 WEST, W.M.; CURRY COUNTY.

