


FINNELL CLAIM OF BENEFICIAL USE MAP T-14054

Received  
SEP 09 2024  
OWRD

CWRE Signature & Stamp

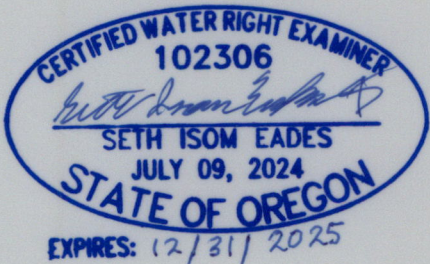

Source: Surface Water - Unnamed Stream Tributary of Nestucca River

POD#2 (45.27749, -123.80419)  
-293' South and 150' West to closest PLSS corner (S 1/16, Sec. 29 & 28)  
-Irrigation Acres: NA  
-ODFW approved fish screen @ POD#2 location  
-No meters/measuring devices required by OWRD

**Legend**

- Domestic Use - Residence
- POD#2 & ODFW Fish Screen
- Pump & Pressure Tank
- Waterline
- Nearest PLSS Corner (S 1/16, Sec.29 & 28)
- PLSS Quarter Quarters
- PLSS Sections
- PLSS Townships
- Ownership Taxlot
- Tillamook County 2021
- Stream

Roads - TL replica

STATUS, SURFACE

- Abandoned or vacated
- Blocked
- Paved
- Surfaced
- Unsurfaced
- Planned

Nearest PLSS Corner (S 1/16, Sec 29 and Sec 28)

FINNELL CLAIM OF BENEFICIAL USE MAP

Transfer # T-14054  
NWSW, Section 28  
T3S, R9E, W.M.,  
Tillamook County, OR



0 100 200 400 Feet

SCALE: 1 INCH = 400 FEET (1:4800)

This map is not intended to provide legal dimensions or locations of property ownership lines