
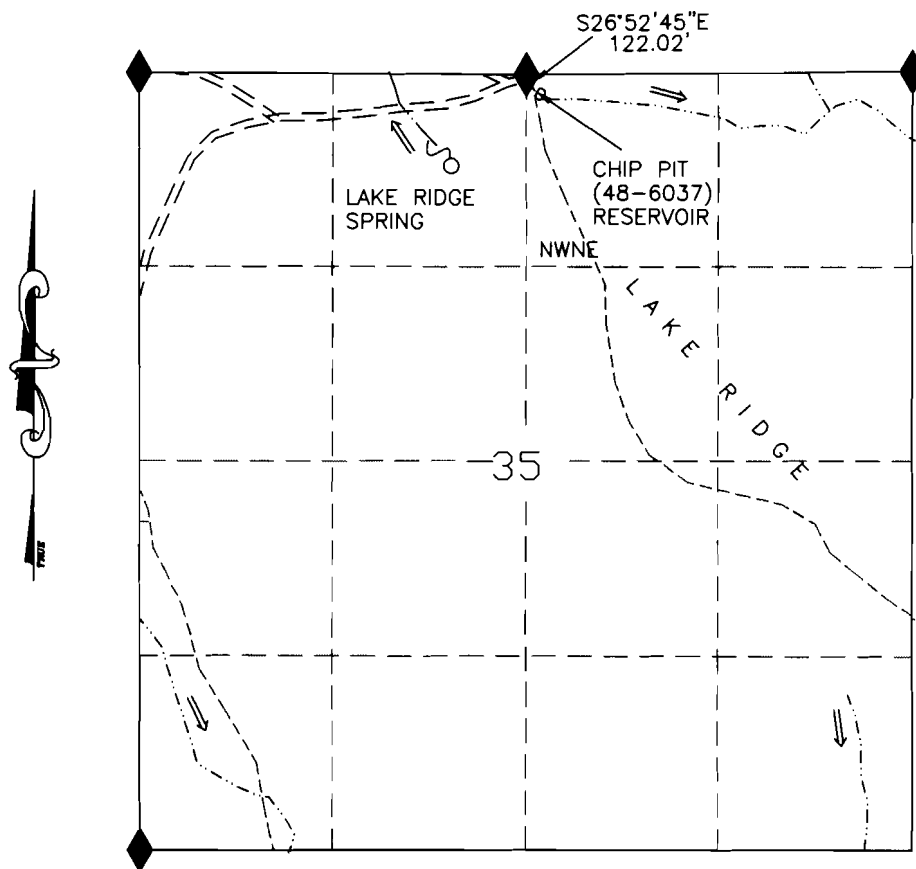


CLAIM OF BENEFICIAL USE MAP

UNDER APPLICATION R-81946 ; PERMIT R-12257

NW1/4 NE1/4 SEC 35 T 22S R 39E W.M.

U.S.G.S. QUAD - SHUMWAY RESERVOIR, OREG. - 7 1/2'

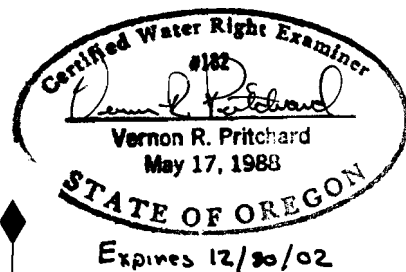

LEGEND

- RESERVOIR
- === ROAD
- - - - CHANNEL
- ◆ FD SEC COR
- - - - TRAIL
- ~ SPRING

CHIP PIT (48-6037) RESERVOIR

RECEIVED

SEP 21 1988

WATER RESOURCES DIV.

1320 660 0 1320
SCALE 1"=1320'

I, *Jerry Easton* Acting ADM Operations/Field Services agree to the findings of the CWRE and do submit this site report and map as my Claim of Beneficial Use of the water as provided under the terms and conditions of my Permit R-12257

Jerry Easton

THIS MAP IS FOR THE PURPOSE OF LOCATING A WATER RIGHT AND IS NOT INTENDED TO PROVIDE LEGAL DIMENSIONS FOR LOCATION OF PROPERTY BOUNDARIES.

ACAD14
DWG FILE: CHIPPITBEN



UNITED STATES DEPARTMENT OF THE INTERIOR BUREAU OF LAND MANAGEMENT DIVISION OF OPERATIONS VALE DISTRICT	
CHIP PIT (48-6037) RESERVOIR	
DRAWN BY: <i>Vernon R. Pritchard</i>	
SURVEYED: <i>Jerry Easton</i>	
APPROVED: <i>Jerry Easton</i> ADM OPERATIONS AND FIELD SERVICES	
DRAWN: CG	SCALE: 1"=1320'
DATE: 11/02/00	SHEET 1 OF 1
DRAWING NO. OR-03-9172.45-1075	