


CLAIM OF BENEFICIAL USE MAP


UNDER APPLICATION R-81944; PERMIT R-12255

NW1/4 NE1/4 SEC 34 T 38S R 43E W.M.

U.S.G.S. QUAD - JACKSON SUMMIT, OREG. - 7 1/2'

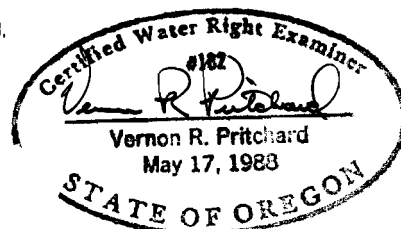

Expires 12/30/02

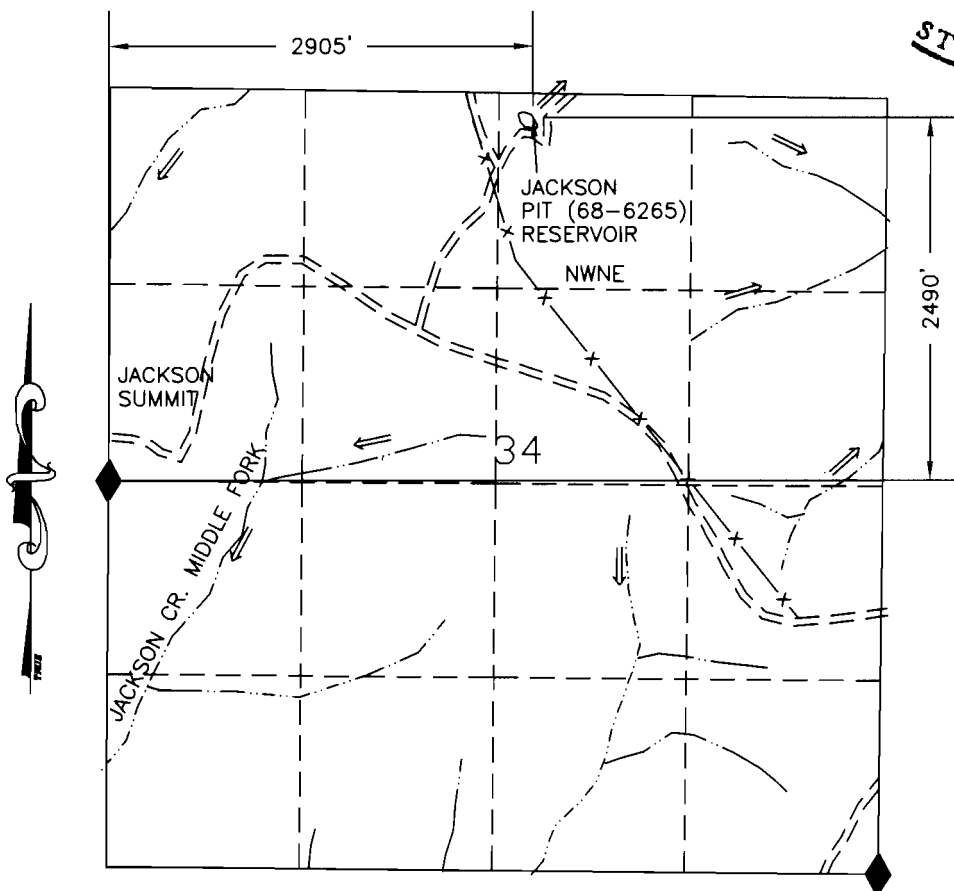

LEGEND

- RESERVOIR
- ROAD
- CHANNEL
- FD SEC COR
- FENCE

JACKSON PIT (68-6265) RESERVOIR

RECEIVED
SEP 21 2001
WATER RIGHTS DIV.

1320 660 0 1320
SCALE 1"=1320'

I, Jerry L. Carter Acting ADM Operations/Field Services agree to the findings of the CWRE and do submit this site report and map as my Claim of Beneficial Use of the water as provided under the terms and conditions of my Permit R-12255.



THIS MAP IS FOR THE PURPOSE OF LOCATING A WATER RIGHT AND IS NOT INTENDED TO PROVIDE LEGAL DIMENSIONS FOR LOCATION OF PROPERTY BOUNDARIES.

ACAD14
DWG FILE JACKSONPBN

UNITED STATES DEPARTMENT OF THE INTERIOR
BUREAU OF LAND MANAGEMENT
DIVISION OF OPERATIONS VALE DISTRICT

JACKSON PIT
(68-6265) RESERVOIR

DRAWN BY: Jerry L. Carter
SURVEYED: Jerry L. Carter
APPROVED: Jerry L. Carter
ADM OPERATIONS AND FIELD SERVICES

DRAWN: CG SCALE: 1"=1320'
DATE: 10/18/00 SHEET 1 OF 1
DRAWING NO. OR-03-9172.45-1057