


WATER RIGHTS PERMIT APPLICATION MAP

Applicant: Timothy E. & Janice M. Heater
 Route 1, Box 113
 Richland, OR 97870
 Application Permit Number: 45438

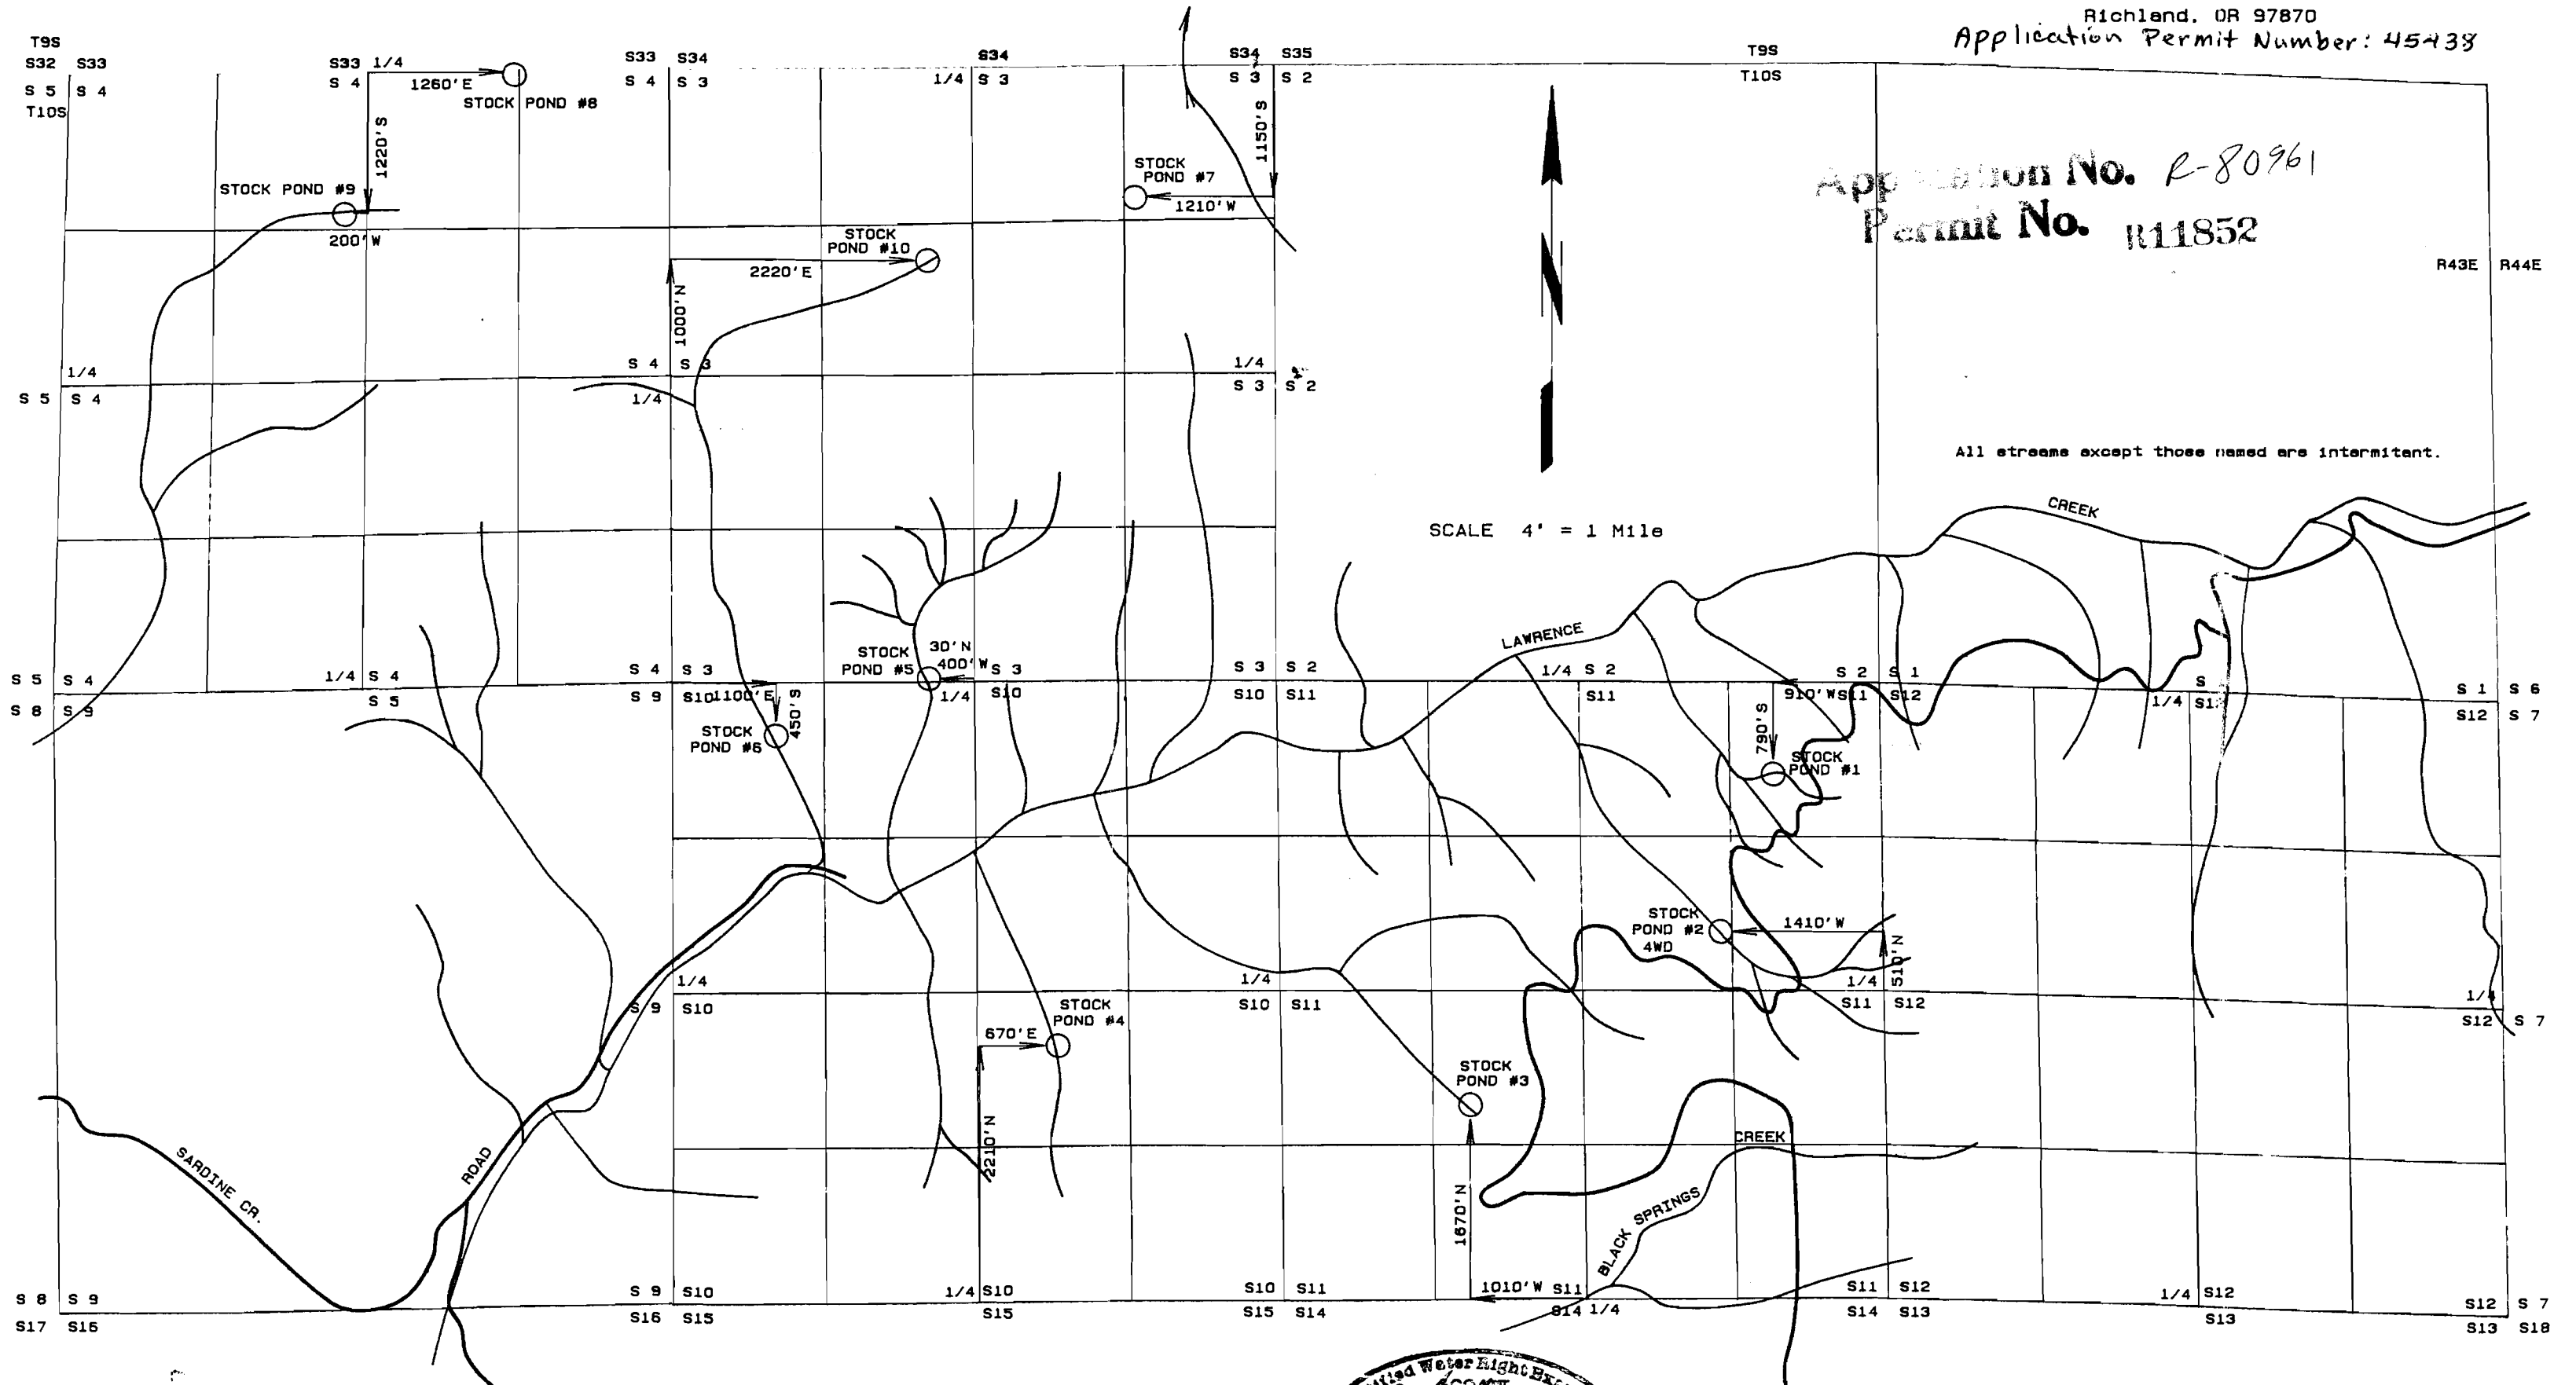


This map is for the purpose of identifying the location of the water right only and has no intent to provide dimensions or location of property ownership lines.



FINAL PROOF MAP
Under Application No. R-80961, Permit No. R-11852


Applicant: Timothy E. & Janice M. Heeter
Route 1, Box 113
Richland, OR 97870

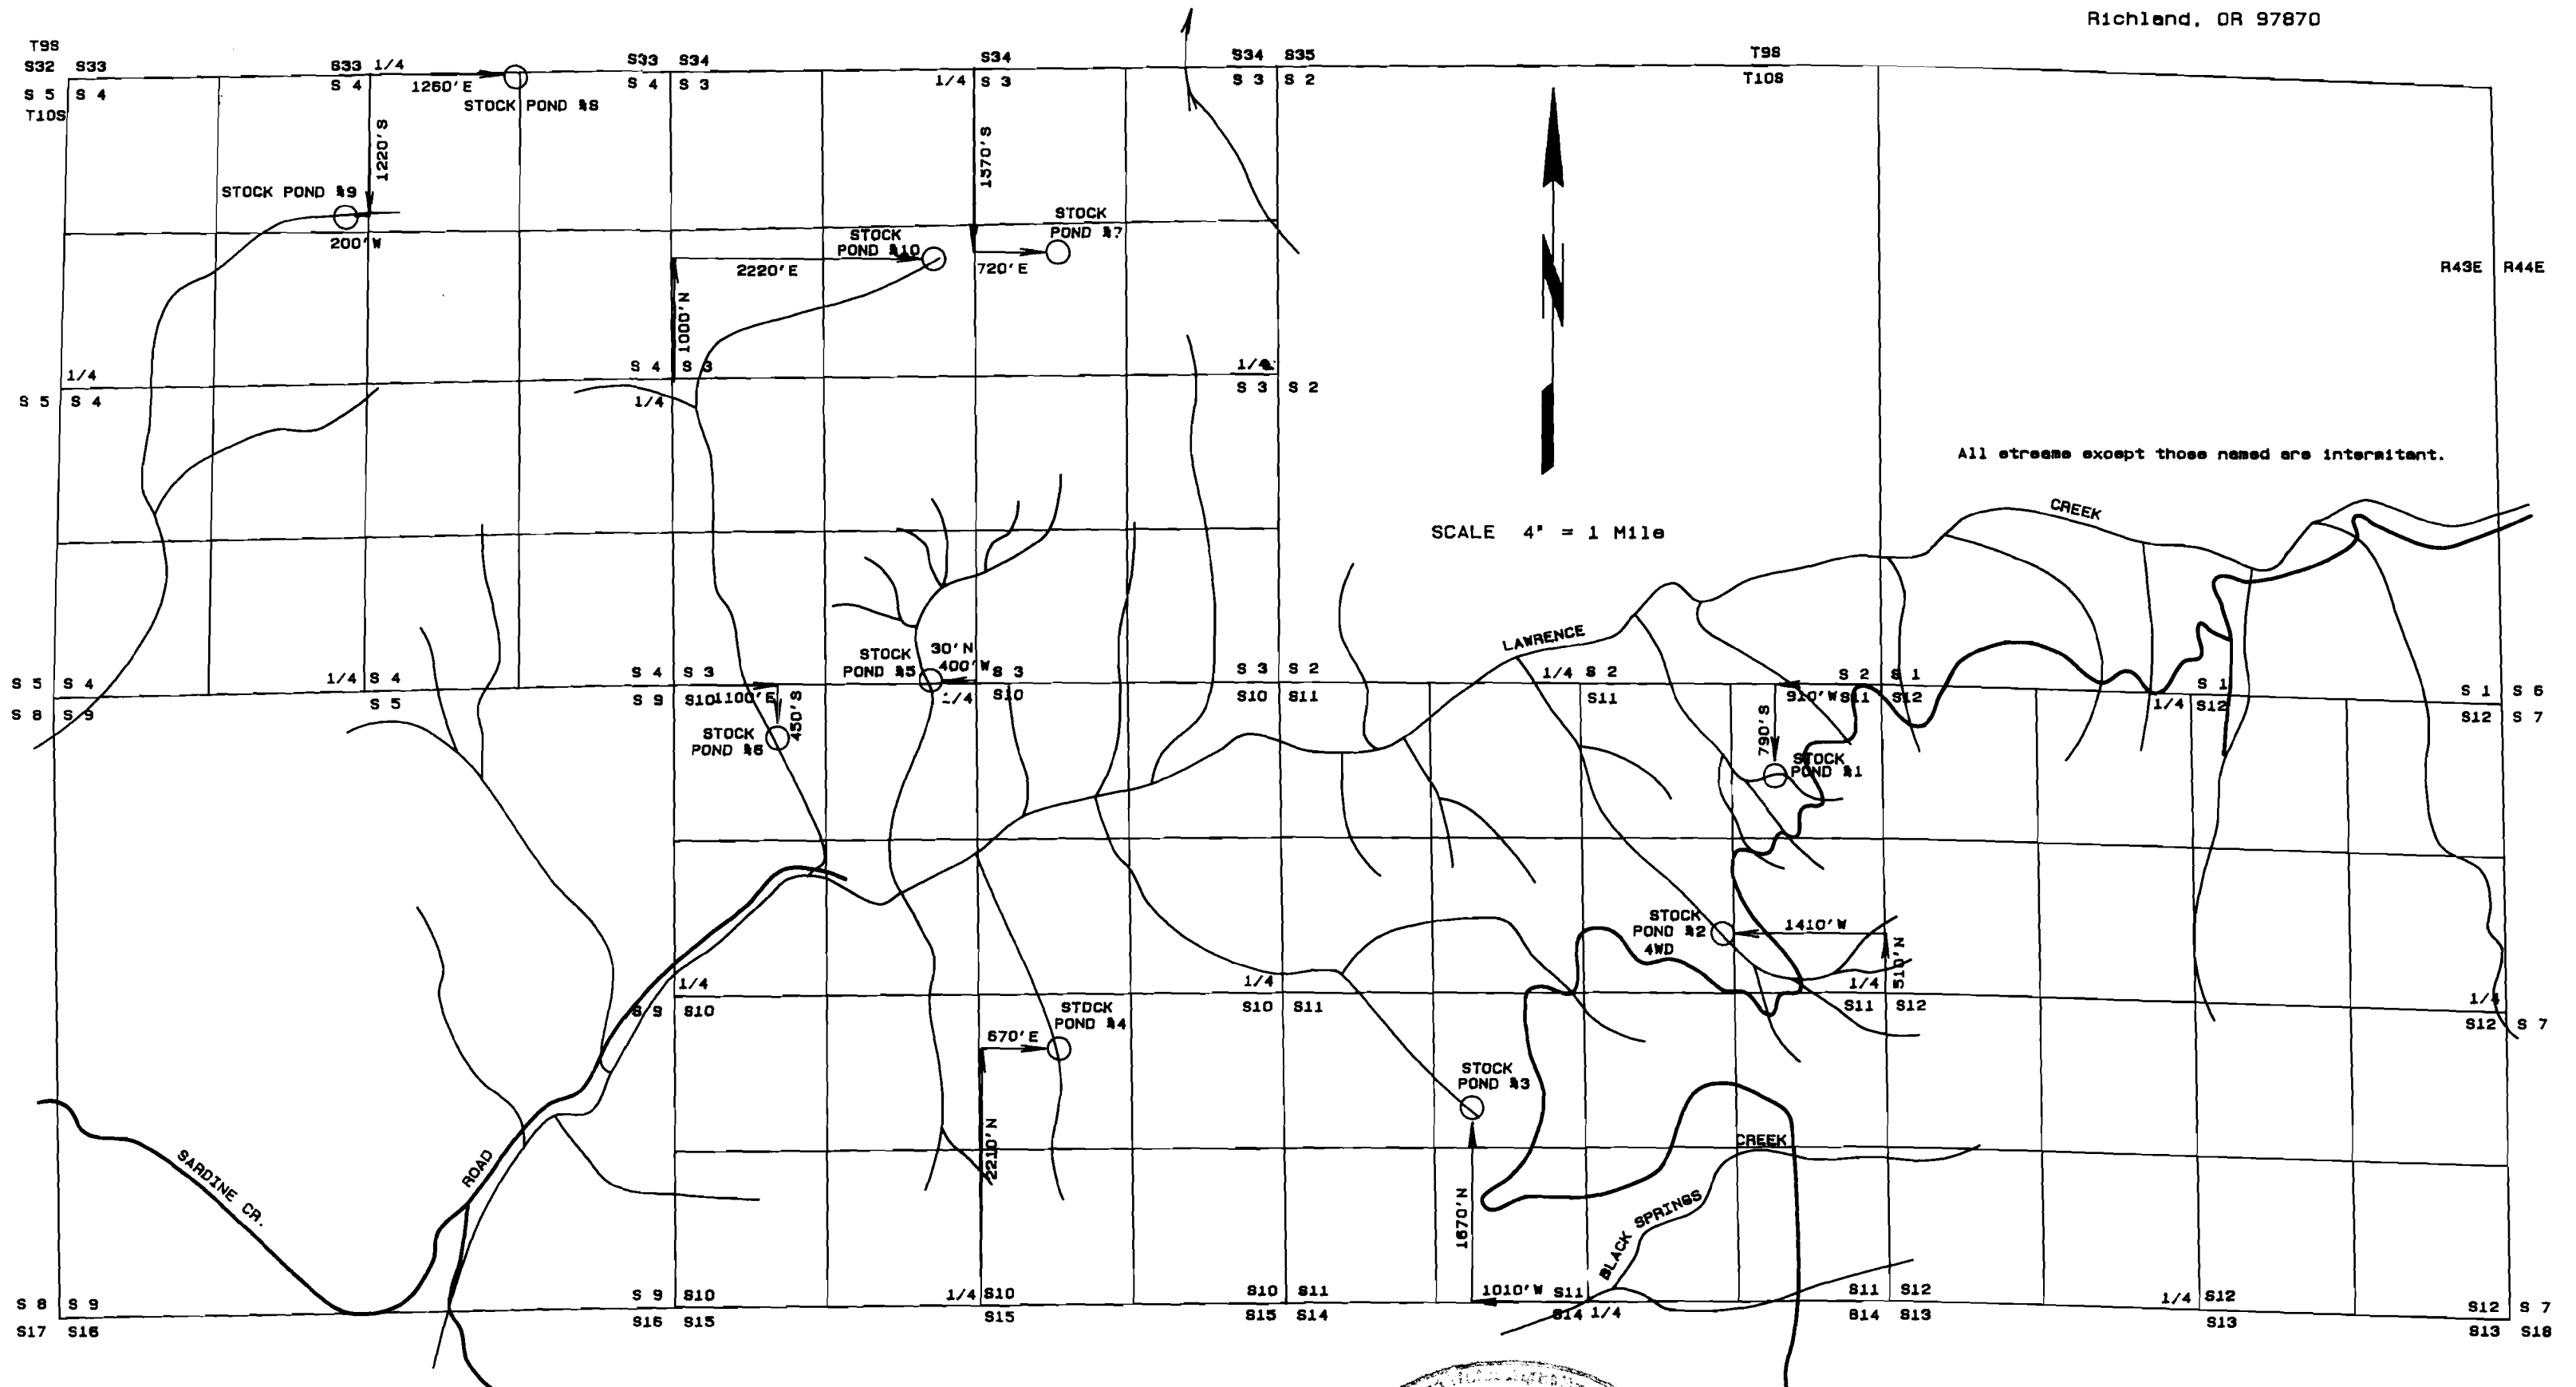

SCALE 4" = 1 Mile

All streams except those named are intermittent.

This map is for the purpose of identifying the location of the water right only and has no intent to provide dimensions or location of property ownership lines.

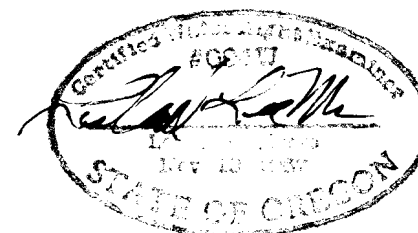

Surveyed November 4, 1997